

**SURVEY &
REMONUMENTATION**

OCT 03 1996

COMMISSION

LAND CORNER RECORDATION CERTIFICATE
Filing Requirement of Act 74, Mich. P.A. 1970

Register's Office }
Gogebic County } ss.

Received for record the
28TH day of MARCH
A. D. 1996 at 11:30 o'clock
A m., and recorded in
Liber 5 of CORNER
on page 340
Lamona Collins Deputy
Register of Deeds

For corners in
Gogebic
(County)

	Located In:	Corner Code #
1. Public Land Survey	T <u>48N.</u> R <u>45 W.</u>	<u>E-12</u>
	T _____ R _____	_____
	T _____ R _____	_____
	T _____ R _____	_____
2. Property Controlling in Section	S _____ T _____ R _____	_____
	S _____ T _____ R _____	_____
3. Miscellaneous Property in Sec.	S _____ T _____ R _____	_____
	S _____ T _____ R _____	_____

Register of Deeds Stamp & File Number

4. Lot No. _____, Recorded Plat _____
5. Private Claims _____

Quarter corner 32 & 33; T.48 N., R.45 W.

I, Richard L. Drahn in a field survey on May 16, _____, 19 95, do hereby certify that under requirements of P.A. 74, Michigan P.A. of 1970, the corner points mentioned in lines 1 and 2 above were in conformance with regulations and rules therefore as required in the current manual of survey instructions of the United States Department of the Interior, Bureau of Land Management or by a decree of a Court of Law and/or that the corner points mentioned in lines 3, 4 and 5 above were in conformance with the rules of the Michigan Board of Land Surveyors or by a Decree of a Court of Law; established, re-established, monumented, re-monumented, recovered, found as expressed below:

	A	B	C	D	E	F	G	H	I	J	K	L	M
2	6	5	4	3	2	1							
3													
4	7	8	9	10	11	12							
5													
6	18	17	16	15	14	13							
7													
8	19	20	21	22	23	24							
9													
10	30	29	28	27	26	25							
11													
12	31	32	33	34	35	36							
13													

NOTE: Not more than 4 corners, all in the same town and range, may be recorded on this certificate.

A. Description of original monument and accessories and/or subsequent restoration:

Original corner established by Austin Burt, Deputy Surveyor on September 25, 1848. Original bearing trees:

Cedar	12"	S.56 E.	15 links	(9.90')
Fir	8"	N.40 W.	25 links	(16.50')

Corner research on file with Gogebic County records. (4/20/95)

B. Description of corner evidence found and/or method applied in restoring or reestablishing corner:


No evidence of original corner or bearing trees found. Ne evidence of subsequent corner restoration found. Corner position re-established on the centerline of an E-W County Road (close to a proportionate location) and on line between the northeast and southeast section corners of section 32; T.48 N., R.45 W.

PEER GROUP APPROVED
Richard L. Drahn 3/27/96
COUNTY REPRESENTATIVE

C. Description of monument for corner and accessories established to perpetuate locating the position of the corner:

At the corner location and 6" below the centerline of the E-W road I set a 2" x 18" iron pipe with a 3" brass cap stamped to read: T.48 N., R.45 W.; 1/2: S-32, S- 33; 1995; R.L.S. 21564. From which I set a 2 1/2" x 30" aluminum pipe reference monument with a 3 1/4" stamped aluminum cap bearing South, 32.11 feet and the following new blazed and scribed bearing trees:

6" Aspen	N.06 W.	31.32 feet
6" Aspen	S.23 E.	33.50 feet
6" Aspen	S.54 W.	35.61 feet
6' Steel rail	S.08 W.	32.20 feet

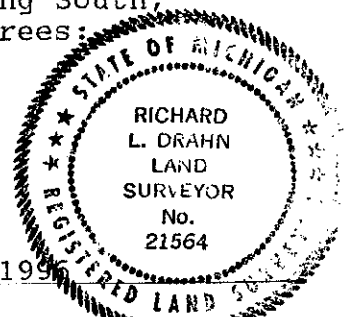

Signed by Richard L. Drahn Date February 26, 1996

Surveyor's Michigan License No. 21564