

MAR 02 2000

SECTION

LAND CORNER RECORDATION CERTIFICATE
Filing Requirement of Act 74, Mich. P.A. 1970

Register's Office }
Gogebic County } ss.

For corners in

<u>Gogebic</u> (County)	Located in:	Corner Code #
1. Public Land Survey	<u>T.48N R45 W.</u>	<u>F-1</u>
	T. R.	
	T. R.	
	<u>T.49N R45W</u>	<u>F-13</u>
2. Property Controlling in Section	S. T. R.	
	S. T. R.	
3. Miscellaneous Property in Sec.	S. T. R.	
	S. T. R.	

Received for record the
22nd day of SEPTEMBER
A. D. 1999 at 1:00 o'clock
1 p. m., and recorded in
Liber 7 of CORNERS
on page 245

Bonnie Collins, Deputy
Register of Deeds

Register of Deeds Stamp & File Number

4. Lot No. _____, Recorded Plat _____
5. Private Claims _____

Quarter Corner 4 & 33; T.48-49 N., R.45 W.

I, Richard L. Drahn, in a field survey on September 7, 1999 do hereby state that under requirements of P.A. 74, Michigan P.A. of 1970, the corner points mentioned in lines 1 and 2 above were in conformance with regulations and rules therefore as required in the current manual of survey instructions of the United States Department of the Interior, Bureau of Land Management or by a decree of a Court of Law and /or that the corner points mentioned in lines 3, 4 and 5 above were in conformance with the rules of the Michigan Board of Land Surveyors or by a Decree of a Court of Law; established, re-established, monumented, recovered, found as expressed below:

	A	B	C	D	E	F	G	H	I	J	K	L	M
1						●							
2	6		5		4		3		2		1		
3													
4	7		8		9		10		11		12		
5													
6	18		17		16		15		14		13		
7													
8	19		20		21		22		23		24		
9													
10	30		29		28		27		26		25		
11													
12	31		32		33		34		35		36		
13						●							

NOTE: Not more than 2 corners, all in the same town and range, may be recorded on this certificate.

A. Description of original monument and accessories and/or subsequent restoration:

Original corner established by Austin Burt on 9/9/1847. Original bearing trees:

Cedar	12"	N.32° E.	48 links	(31.68')
Spruce	16"	N.62° W.	19 links	(12.54')

B. Description of corner evidence found and/or method applied in restoring or reestablishing corner:

Restored corner position at record bearing and distance from the remains of the original Cedar bearing tree. It is now a 16-20" decayed Cedar stump, broken up by logging operations. No evidence remains of the original Spruce bearing tree. A very old downed 6" Cedar, squared for the corner bears N.78° E. 9.7' from the original corner location. An 18" Cedar squared for the corner by L.W. Verch on 10/83 bears N.86° E. 12.5' from the original corner location.


corner research on file with Gogebic County records.

C. Description of monument for corner and accessories established to perpetuate locating the position of the corner:

At the corner position I set a 3/4" X 4" aluminum rod monument with a 3 1/4" stamped aluminum cap and the following new B.T.s (all measurements taken to a nail in side of tree):

Cedar	9"	S.26° E.	30.49'
Cedar	14"	S.50° W.	21.27'
Black Ash	6"	N.28° W.	8.41'
Steel sign rail	6'	N.61° E.	2.50'

FREE GROUP APPROVED
Richard L. Drahn 9/21/99
COUNTY REGISTER

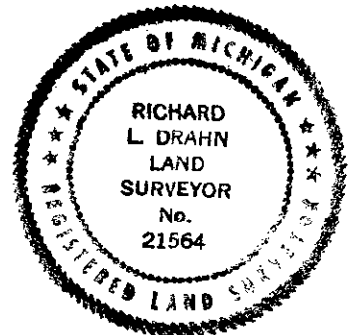

Signed by Richard L. Drahn Date September 12, 1999

Surveyor's Michigan License No. 21564

FORM APPROVED BY MICHIGAN STATE BOARD OF PROFESSIONAL SURVEYORS, JAN. 28, 1971
REVISED MAY 14, 1976
REVISED JAN., 1983
REVISED OCT., 1986