

SURVEY & REMONUMENTATION

SEP 08 1998

SECTION

LAND CORNER RECORDATION CERTIFICATE
Filing Requirement of Act 74, Mich. P.A. 1970

For corners in Gogebic

(County)	Located In:	Corner Code #
1. Public Land Survey	Section 34 48N 45W	G-11
	T___ R___	_____
	T___ R___	_____
	T___ R___	_____
	T___ R___	_____
2. Property Controlling in Section	S___ T___ R___	_____
	S___ T___ R___	_____
3. Miscellaneous Property in Sec.	S___ T___ R___	_____
	S___ T___ R___	_____

Register's Office }
Gogebic County } ss.

Received for record the
14TH day of MAY
A. D. 1998 at 3:30 o'clock
P m., and recorded in
Liber 6 of CORNERS
on page 389
Ramona Collins Dep.
Register of Deeds


Register of Deeds Stamp & File Number

4. Lot No. _____, Recorded Plat _____
5. Private Claims _____

Section corner to 27, 28 & 34 T48N, R45W

I, John R. Garske, in a field survey on December 11, 1997 do hereby state that under requirements of P.A. 74, Michigan P.A. of 1970, the corner points mentioned in lines 1 and 2 above were in conformance with regulations and rules therefore as required in the current manual of survey instructions of the United States Department of the Interior, Bureau of Land Management or by a decree of a Court of Law and/or that the corner points mentioned in lines 3, 4 and 5 above were in conformance with the rules of the Michigan Board of Land Surveyors or by a Decree of a Court of Law; established, re-established, monumented, recovered, found as expressed below:

NOTE: Not more than 2 corners, all in the same town and range, may be recorded on this certificate.

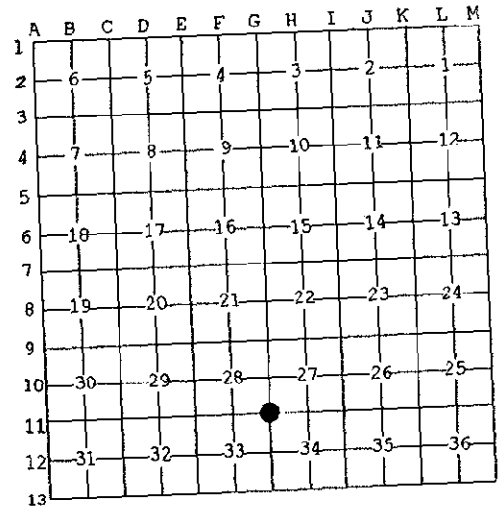

A. Description of original monument and accessories and/or subsequent restoration:

Original Township survey by Austin Burt, D.S. in 1848
He set a wood post from which:
Sugar 12" S30°W 8 links
Yellow Birch 10" N55°E 27 links

B. Description of corner evidence found and/or method applied in restoring or reestablishing corner:

No original evidence exists. I established the corner at the centerline intersection of County Road 519 and Kronberg Road. This location is the most logical position for the section corner, it fits well with occupation lines in the area.

Ties to other corners are:
S89°-33'-37"E 2638.25 to 1/4 corner 27 & 34
S00°-58'-54"E 2651.16 to 1/4 corner 33 & 34

(Research on file)


PEER GROUP APPROVED
Richard P. Drahn 5/13/98
COUNTY REPRESENTATIVE

C. Description of monument for corner and accessories established to perpetuate locating the position of the corner:

I set a 5/8" x 10" long rod with 3 1/4" dia. brass cap stamped to identify the corner 2" below the pavement from which:
Reference monumnet (R.M.) Due west 33.00 feet steel sign rail - 1.50'
(R.M. - 2 1/2" dia. x 30" long alum pipe with 3 1/4" alum. cap)
4" W. Ash N29°W 58.81 feet
7" Sugar Maple S50°W 39.63 feet
14" Sugar maple S32°E 72.39 feet

Signed by John R. Garske
Surveyor's Michigan License No. 28410

Date 5/12/98

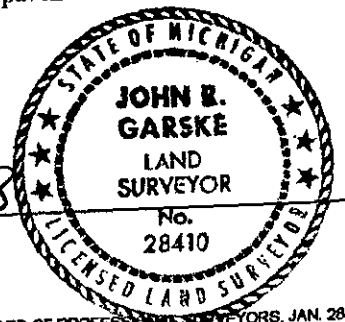

1112 389