

**SURVEY &
REMONUMENTATION**

SEP 08 1998

LAND CORNER RECORDATION CERTIFICATE
Filing Requirement of Act 74, Mich. P.A. 1970

Register's Office }
Gogebic County } ss.

For corners in SECTION

<u>Gogebic</u> (County)	Located In:	Corner Code #
1. Public Land Survey	Section <u>34</u> T <u>48N</u> R <u>45W</u>	<u>G-12</u>
	T ___ R ___	_____
	T ___ R ___	_____
	T ___ R ___	_____
2. Property Controlling in Section	S ___ T ___ R ___	_____
	S ___ T ___ R ___	_____
3. Miscellaneous Property in Sec.	S ___ T ___ R ___	_____
	S ___ T ___ R ___	_____

Received for record the
18th day of JUNE
A. D. 1998 at 1:30 o'clock
P m., and recorded in
Liber 7 of CORNERS
on page 14.
Ramona Collins Deputy
Register of Deeds

Register of Deeds Stamp & File Number

4. Lot No. _____, Recorded Plat _____
5. Private Claims _____

1/4 Corner Sections 33 & 34, T48N, R45W

I, John R. Garske, in a field survey on May 27, 1998, do hereby state that under requirements of P.A. 74, Michigan P.A. of 1970, the corner points mentioned in lines 1 and 2 above were in conformance with regulations and rules therefore as required in the current manual of survey instructions of the United States Department of the Interior, Bureau of Land Management or by a decree of a Court of Law and/or that the corner points mentioned in lines 3, 4 and 5 above were in conformance with the rules of the Michigan Board of Land Surveyors or by a Decree of a Court of Law; established, re-established, monumented, recovered, found as expressed below:


NOTE: Not more than 2 corners, all in the same town and range, may be recorded on this certificate.

A	B	C	D	E	F	G	H	I	J	K	L	M
1												
2	6		5		4		3		2		1	
3												
4	7		8		9		10		11		12	
5												
6	18		17		16		15		14		13	
7												
8	19		20		21		22		23		24	
9												
10	30		29		28		27		26		25	
11												
12	31		32		33		34		35		36	
13												

A. Description of original monument and accessories and/or subsequent restoration:

Original Survey by Austin Burt, D.S. in Sept.. 1848.
He set a cedar post from which:
Sugar 8" - S40°E - 16 links
Sugar 10" - N65°W - 4 links

1889 Plat of Thomaston by Andrew Holmes shows 1/4 corner at Southwest corner of Plat.
1977 Survey by John Goss shows 1/4 corner on map.

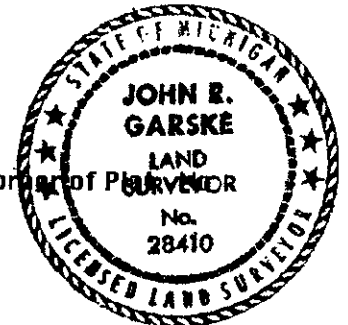

B. Description of corner evidence found and/or method applied in restoring or reestablishing corner:

At the 1/4 corner location I found a 6 "dia. concrete monument with a 1 1/4 " dia. steel rod protruding 10" above. The monument is in poor condition somewhat bent. There are ancient fence lines running east and north from this position. I was unable to find any evidence of the original or subsequent bearing trees. I measured N00°-03'-05"E - 2647.48 feet to the Section Corner of 27, 28, 33 and 34.

(Research on file)

C. Description of monument for corner and accessories established to perpetuate locating the position of the corner:

I replaced the concrete monument with a stamped aluminum pipe monument 30" long x 2 1/2 " dia. with a 3 1/4 dia. cap and laid the concrete monument along side, from which I established:

Sugar	6"	N13°E	13.67 feet
Sugar	10"	N47°E	25.42 feet
Sugar	7"	S40°E	47.83 feet
Maple	9"	S60°W	8.80 feet
Steel sign post		NWly	1.36 feet

PEER GROUP APPROVED
Richard L. Drizin 06/17/98
COUNTY REPRESENTATIVE

Signed by John R. Garske
Surveyor's Michigan License No. 28410

Date 6/16/98