

LAND CORNER RECORDATION CERTIFICATE
Filing Requirement of Act 74, Mich. P.A. 1970

For corners in
Gogebic
 (County)

Located In: _____ Corner Code # _____

- | | | |
|------------------------------------|---------------------------|-------------|
| 1. Public Land Survey Section 4 | T <u>47N</u> R <u>45W</u> | <u>G-1</u> |
| | T _____ R _____ | _____ |
| | T _____ R _____ | _____ |
| | T <u>48N</u> R <u>45W</u> | <u>G-13</u> |
| 2. Property Controlling in Section | S _____ T _____ R _____ | _____ |
| | S _____ T _____ R _____ | _____ |
| 3. Miscellaneous Property in Sec. | S _____ T _____ R _____ | _____ |
| | S _____ T _____ R _____ | _____ |

Register's Office }
 Gogebic County } ss.

Received for record the
30th day of DECEMBER
 A. D. 1993 at 12:20 o'clock
P m., and recorded in
 Liber 4 of CORNERS
 on page 319
Betty Saari Deputy
 Register of Deeds

Register of Deeds Stamp & File Number

4. Lot No. _____, Recorded Plat _____
 5. Private Claims _____
Section corner common to Sections 33, 34, 3 & 4, T48-47N, R45W.

	A	B	C	D	E	F	G	H	I	J	K	L	M
2	6		5		4		3		2		1		
3													
4	7		8		9		10		11		12		
5													
6	18		17		16		15		14		13		
7													
8	19		20		21		22		23		24		
9													
10	30		29		28		27		26		25		
11													
12	31		32		33		34		35		36		
13													

I, John R. Garske, in a field survey on December 2, 1993, do hereby certify that under requirements of P.A. 74, Michigan P.A. of 1970, the corner points mentioned in lines 1 and 2 above were in conformance with regulations and rules therefore as required in the current manual of survey instructions of the United States Department of the Interior, Bureau of Land Management or by a decree of a Court of Law and/or that the corner points mentioned in lines 3, 4 and 5 above were in conformance with the rules of the Michigan Board of Land Surveyors or by a Decree of a Court of Law; established, re-established, monumented, re-monumented, recovered, found as expressed below:

NOTE: Not more than 4 corners, all in the same town and range, may be recorded on this certificate.

A. Description of original monument and accessories and/or subsequent restoration:

Original survey by Austin Burt, U.S.D.S., on September 4, 1847. Set Maple post from which a 10" sugar bears N57°E, 59 links and a 12" fir - N65°W, 12 links. Bearing trees:

No evidence found.

B. Description of corner evidence found and/or method applied in restoring or reestablishing corner:

This corner position was shown on plans for the City of Wakefield's lagoon system but was apparently destroyed during construction. I reestablished the corner from information furnished by the City of Wakefield from existing lagoon roads and fences. The corner position falls at the center line intersection of the extension of N-S and a westerly trail. Measurements to known corner positions west and south were used to verify the corner's location.


PEER GROUP APPROVED

Richard P. Drakun 4/7/84
 COUNTY REPRESENTATIVE

C. Description of monument for corner and accessories established to perpetuate locating the position of the corner:

Set 3/4" x 30" long rebar with standard Bernsten 3 1/2" aluminum cap stamped: County Remonumentation; T48N, R45W; S-33; S-34; S-4; S-5; T47N; 1993; RLS 28410. Established the following bearing trees and reference objects:

- 7" H. maple - N55°W - 39.08 feet
- Twin 5" elm - N26°E - 52.03 feet
- 6" H. maple - S55°E - 26.30 feet
- East side west gate post - S10°W - 55.27 feet
- Steel sign post - east - 1.36 feet

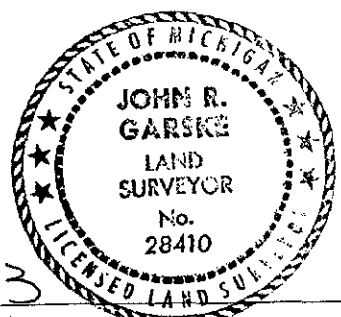

Signed by John R. Garske
 Surveyor's Michigan License No. 28410

Date 12/13/93