

LAND CORNER RECORDATION CERTIFICATE
Filing Requirement of Act 74, Mich. P.A. 1970

For corners in

<u>Gogebic</u> (County)	Located In:	Corner Code #
1. Public Land Survey	T48 N R45 W.	H-7
	T ___ R ___	_____
	T ___ R ___	_____
	T ___ R ___	_____
2. Property Controlling in Section	S ___ T ___ R ___	SURVEY & REMONUMENTATION
	S ___ T ___ R ___	_____
3. Miscellaneous Property in Sec.	S ___ T ___ R ___	JAN 05 2001
	S ___ T ___ R ___	_____

Register's Office }
 Gogebic County } ss.


Received for record the
2ND day of OCTOBER
 A. D. 2000 at 10:50 o'clock
A m., and recorded in
 Liber B of CORNERS
 on page 29
Ramona Collins, Deputy
 Register of Deeds

Register of Deeds Stamp & File Number

4. Lot No. _____, Recorded Plat _____ SECTION _____
 5. Private Claims _____

¼ Corner 15 & 22; T.48 N., R.45 W.

I, Richard L. Drahn, in a field survey on Sept. 25, 2000 do hereby state that under requirements of P.A. 74, Michigan P.A. of 1970, the corner points mentioned in lines 1 and 2 above were in conformance with regulations and rules therefore as required in the current manual of survey instructions of the United States Department of the Interior, Bureau of Land Management or by a decree of a Court of Law and /or that the corner points mentioned in lines 3, 4 and 5 above were in conformance with the rules of the Michigan Board of Land Surveyors or by a Decree of a Court of Law; established, re-established, monumented, recovered, found as expressed below:

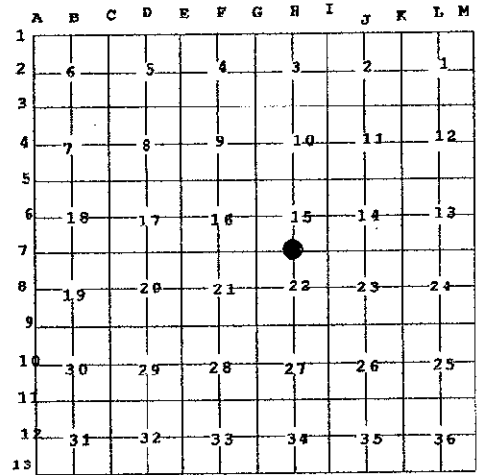

NOTE: Not more than 2 corners, all in the same town and range, may be recorded on this certificate.

A. Description of original monument and accessories and/or subsequent restoration:

Original corner established by Austin Burt on 9/23/1848. Original bearing trees:
 Sugar 14" S.18° W. 32 links (21.12')
 Fir 12 N.31° E. 28 links (18.48')

B. Description of corner evidence found and/or method applied in restoring or reestablishing corner:

I restored the corner position at record bearing and distance from the remains of the two original bearing trees. The first is a series of root holes with black flakes of Sugar Maple wood. The second one is now a shallow windthrown stump hole. The 1.02 chain distance east to "top of hill" and the 0.98 chain distance west to "ascend (foot) hill, check to within 7 feet.

A ½" metal conduit pipe bears N.01° W. 42.0' from the original corner location.

Corner research on file with Gogebic County records.

C. Description of monument for corner and accessories established to perpetuate locating the position of the corner:

At the corner position I set a 2" X 30" aluminum pipe with a 3 ¼' stamped aluminum cap and the following new blazed and scribed bearing trees: (measurements taken to a 10p nail in the side of the tree)

Cedar	11"	S.39° W.	24.82'
Sugar Maple	11"	N.81° E.	3.29'
Sugar Maple	4"	N.31° W.	25.19'
Steel sign rail	6'	N.71° W.	2.83'

Richard L. Drahn
 Richard L. Drahn 9/27/00
 COUNTY REGISTER



Signed by Richard L. Drahn Date September 27, 2000

Surveyor's Michigan License No. 21564

FORM APPROVED BY MICHIGAN STATE BOARD OF PROFESSIONAL SURVEYORS, JAN. 28, 1971

USFS N-15

REVISED MAY 14, 1976

REVISED JAN., 1983
 REVISED OCT., 1995