

Register's Office }
Gogebic County } ss.

LAND CORNER RECORDATION CERTIFICATE
Filing Requirement of Act 74, Mich. P.A. 1970

Received for record the
2ND day of OCTOBER
A. D. 2000 at 10:50 o'clock
A m., and recorded in
Liber B of CORNERS
on page 31
Ramona Collins Deputy
Register of Deeds

For corners in

Gogebic Located In: Corner Code #
(County)

1. Public Land Survey T48 N R45 W. 1-7
T R
T R
T R **SURVEY &**
EMONUMENTATION

2. Property Controlling S T R
in Section S T R
3. Miscellaneous S T R
Property in Sec. S T R


JAN 05 2001
SECTION

Register of Deeds Stamp & File Number

4. Lot No. _____, Recorded Plat _____
5. Private Claims _____

Section Corner 14, 15, 22 & 23; T.48 N., R.48 W.

I, Richard L. Drahn, in a field survey on August 24, 2000 do hereby state that under requirements of P.A. 74, Michigan P.A. of 1970, the corner points mentioned in lines 1 and 2 above were in conformance with regulations and rules therefore as required in the current manual of survey instructions of the United States Department of the Interior, Bureau of Land Management or by a decree of a Court of Law and /or that the corner points mentioned in lines 3, 4 and 5 above were in conformance with the rules of the Michigan Board of Land Surveyors or by a Decree of a Court of Law; established, re-established, monumented, recovered, found as expressed below:

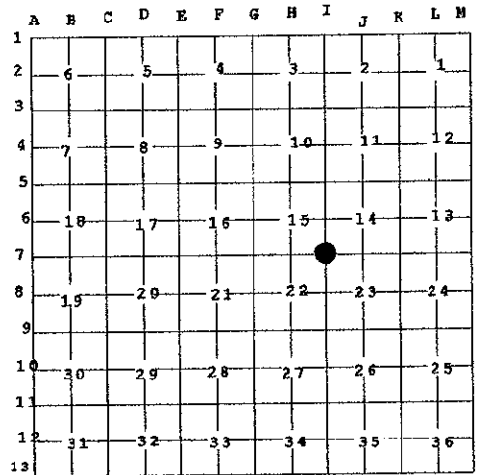

NOTE: Not more than 2 corners, all in the same town and range, may be recorded on this certificate.

A. Description of original monument and accessories and/or subsequent restoration:
Original corner established by Austin Burt on 9/20/1854. Original bearing trees:
1848

Cedar	16"	S.38 W.	48 links	(31.68')
Hemlock	12"	N.36 E.	04 links	(2.64')

B. Description of corner evidence found and/or method applied in restoring or reestablishing corner:

I restored the corner position at record bearing and distance from the remains of the two original bearing trees. The first one is a 20-24" badly burned and decayed Cedar stump with portions of the B.T. overgrowth still visible. The second one is now a series of root holes with portions of unidentifiable conifer wood in the root holes.

A 12" Aspen, squared for the corner bears N.12 W., 20.1 feet from the original corner location.

Corner research on file with Gogebic County records.

C. Description of monument for corner and accessories established to perpetuate locating the position of the corner:

At the corner position I set a 30" long aluminum pipe with a 3 1/4" stamped aluminum cap and the following new blazed and scribed bearing trees: (measurements taken to a 10p nail in the side of the tree)

Cedar	6"	N.02 E.	24.19'
Red Maple	5"	N.75 E.	26.98'
White Spruce	8"	S.13 W.	13.40'
Steel sign rail	6'	N.87 W.	1.98'

Richard L. Drahn 9/27/00
REGISTERED LAND SURVEYOR



Signed by Richard L. Drahn Date September 23, 2000

Surveyor's Michigan License No. 21564

FORM APPROVED BY MICHIGAN STATE BOARD OF PROFESSIONAL SURVEYORS, JAN. 28, 1971.

REVISED MAY 14, 1975