

SURVEY &  
REMONUMENTATION

SEP 08 1998

LAND CORNER RECORDATION CERTIFICATE  
Filing Requirement of Act 74, Mich. P.A. 1970

Register's Office }  
Gogebic County } ss.

SECTION

For corners in

<u>Gogebic</u> (County)	Located In:	Corner Code #
1. Public Land Survey	Section 34T 48NR 45W	1-11
	T ___ R ___	_____
	T ___ R ___	_____
	T ___ R ___	_____
2. Property Controlling in Section	S ___ T ___ R ___	_____
	S ___ T ___ R ___	_____
3. Miscellaneous Property in Sec.	S ___ T ___ R ___	_____
	S ___ T ___ R ___	_____

Received for record the  
18<sup>th</sup> day of JUNE  
A. D. 1998 at \_\_\_\_\_ o'clock  
P m., and recorded in  
Liber 7 of CORNERS  
on page 15

*Ramona Collins, Deputy*  
Register of Deeds

Register of Deeds Stamp & File Number

4. Lot No. \_\_\_\_\_, Recorded Plat \_\_\_\_\_  
5. Private Claims \_\_\_\_\_

Section Corner to 26, 27, 34 & 35, T48N, R45W

I, John R. Garske, in a field survey on May 28, 1998, do hereby state that under requirements of P.A. 74, Michigan P.A. of 1970, the corner points mentioned in lines 1 and 2 above were in conformance with regulations and rules therefore as required in the current manual of survey instructions of the United States Department of the Interior, Bureau of Land Management or by a decree of a Court of Law and /or that the corner points mentioned in lines 3, 4 and 5 above were in conformance with the rules of the Michigan Board of Land Surveyors or by a Decree of a Court of Law, established, re-established, monumented, recovered, found as expressed below:


NOTE: Not more than 2 corners, all in the same town and range, may be recorded on this certificate.

	A	B	C	D	E	F	G	H	I	J	K	L	M
1													
2	6		5		4		3		2		1		
3													
4	7		8		9		10		11		12		
5													
6	18		17		16		15		14		13		
7													
8	19		20		21		22		23		24		
9													
10	30		29		28		27		26		25		
11													
12	31		32		33		34		35		36		
13													

A. Description of original monument and accessories and/or subsequent restoration:

Original Survey by Austin Burt, D.S. in Sept., 1848.  
He set a sugar post from which:  
Hemlock 12" - S15°E - 21 links  
Hemlock 18" - N25°W - 16 links

1925-Chicago & Northwestern R.R. plans show a stake at the corner 934' North of a  
culvert and 658' west of a North-South spur line.

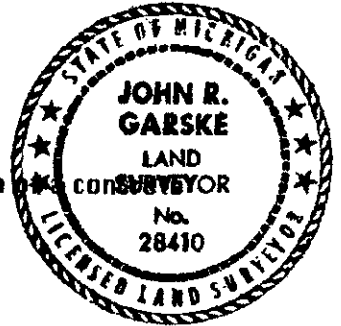

B. Description of corner evidence found and/or method applied in restoring or reestablishing corner:

At the corner position I found a wood post next to a 6" Maple blazed on 4 sides. Blue lines run in all four directions from this point. The 6" Maple has a 1966 Keweenaw tag and a 1990 Champion Tag on it. This location checks reasonable well with the old C & NW R.R. ties, which is how we found it. Distances to known corners also check well. 1/4 corner 27 & 34 - N89°-33'-37"W - 2638.25, 1/4 corner 34 & 35 - S00°-04'-15"W - 2633.93 feet.

(Research on file)

C. Description of monument for corner and accessories established to perpetuate locating the position of the corner:

I replaced the wooden post with a 5/8" x 30" iron rod with a 3 1/4" dia. stamped Aluminum cap at the base of the blazed tree from which I established:

Sugar	8"	North	43.55 feet
Hemlock	10"	N73°E	17.05 feet
Sugar	5"	South	39.35 feet
Sugar	7"	N58°W	32.73 feet
Steel sign post		NEly	1.91 feet

DEED GROUP APPROVED  
*Richard L. Dralun* 6/17/98  
COUNTY REPERMUTATED

Signed by John R. Garske  
Surveyor's Michigan License No. 28410

Date 6/17/98