

**SURVEY &
REMONUMENTATION**

SEP 08 1998

LAND CORNER RECORDATION CERTIFICATE
Filing Requirement of Act 74, Mich. P.A. 1970

Register's Office }
Gogebic County } ss.

For corners in SECTION

<u>Gogebic</u> (County)	Located In:	Corner Code #
1. Public Land Survey	Section 34 T48N R45W	I-12
	T___ R___	_____
	T___ R___	_____
	T___ R___	_____
2. Property Controlling in Section	S___ T___ R___	_____
	S___ T___ R___	_____
3. Miscellaneous Property in Sec.	S___ T___ R___	_____
	S___ T___ R___	_____

Received for record the
18th day of JUNE
A. D. 1998 at _____ o'clock
9 m., and recorded in
Liber 7 of CORNERS
on page 16
Ramona Collins Deputy
Register of Deeds

Register of Deeds Stamp & File Number

4. Lot No. _____, Recorded Plat _____
5. Private Claims _____

1/4 Corner Sections 34 & 35, T48N, R45W

I, John R. Garske, in a field survey on May 27, 1998 do hereby state that under requirements of P.A. 74, Michigan P.A. of 1970, the corner points mentioned in lines 1 and 2 above were in conformance with regulations and rules therefore as required in the current manual of survey instructions of the United States Department of the Interior, Bureau of Land Management or by a decree of a Court of Law and /or that the corner points mentioned in lines 3, 4 and 5 above were in conformance with the rules of the Michigan Board of Land Surveyors or by a Decree of a Court of Law; established, re-established, monumented, recovered, found as expressed below:


NOTE: Not more than 2 corners, all in the same town and range, may be recorded on this certificate.

A	B	C	D	E	F	G	H	I	J	K	L	M
1												
2	6		5		4		3		2		1	
3												
4	7		8		9		10		11		12	
5												
6	18		17		16		15		14		13	
7												
8	19		20		21		22		23		24	
9												
10	30		29		28		27		26		25	
11												
12	31		32		33		34	●	35		36	
13												

A. Description of original monument and accessories and/or subsequent restoration:

Original Survey by Austin Burt, D.S. in Sept., 1848.
He set a cedar post from which:
cedar 12" - S43°E - 19 links
cedar 12" - N83°W - 15 links

1925 - Chicago & Northwestern R.R. plans show the corner at 1550 feet north of concrete culvert along the R.R. centerline then west 336 feet.

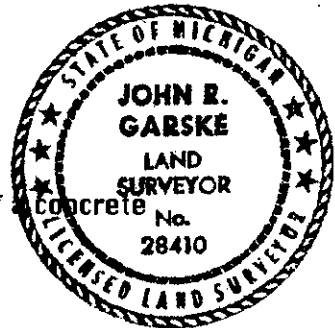

B. Description of corner evidence found and/or method applied in restoring or reestablishing corner:

I found a 2 inch iron pipe at the corner location which I found by using the 1925 C & NW R.R. ties. 5 feet North of the pipe is a 10" Maple with a rusted and Folded corner tag somewhat grown in to the tree. No occupation lines or any other B.T.'s could be found. This corner checks well with the old R.R. plans and is S00°-04'-15"W - 2633.95' of the Northeast corner of Section 34.

(Research on file)

C. Description of monument for corner and accessories established to perpetuate locating the position of the corner:

I set a 5/8" x 30" rebar with a stamped 3/4" aluminum cap inside the iron pipe I found and grouted it in with quickcrete from which I established:

B.Ash	5"	N67°E	12.06 feet
B.Ash	5"	S03°W	8.27 feet
Maple	10"	N75°W	18.97 feet
Cedar	6"	N04°W	20.38 feet
Steel sign post		NWly	1.42 feet

PEER GROUP APPROVED
Richard L. Dredman 6/17/98
COUNTY REGISTER

Signed by John R. Garske
Surveyor's Michigan License No. 28410

Date 6/16/98