

Register's Office }
Gogebic County } ss.

LAND CORNER RECORDATION CERTIFICATE
Filing Requirement of Act 74, Mich. P.A. 1970

Received for record the
2ND day of OCTOBER
A. D. 2000 at 10:50 o'clock
A m., and recorded in
Liber B of GOGEBIC

For corners in

Gogebic Located In: _____ Corner Code # _____
(County)
1. Public Land Survey T48 N R45 W. _____ J-9 _____
T _____ R _____
T _____ R _____ SURVEY &
T _____ R _____ MONUMENTATION
2. Property Controlling S _____ T _____ R _____
in Section S _____ T _____ R _____
3. Miscellaneous S _____ T _____ R _____
Property in Sec. S _____ T _____ R _____
SECTION

page 35
Ramona Collins, Deputy
Register of Deeds

Register of Deeds Stamp & File
Number

4. Lot No. _____, Recorded Plat _____
5. Private Claims _____

¼ Corner 23 & 26; T.48 N., R.45 W.

I, Richard L. Drahn, in a field survey on Sept. 13, 2000 do hereby state that under requirements of P.A. 74, Michigan P.A. of 1970, the corner points mentioned in lines 1 and 2 above were in conformance with regulations and rules therefore as required in the current manual of survey instructions of the United States Department of the Interior, Bureau of Land Management or by a decree of a Court of Law and /or that the corner points mentioned in lines 3, 4 and 5 above were in conformance with the rules of the Michigan Board of Land Surveyors or by a Decree of a Court of Law; established, re-established, monumented, recovered, found as expressed below:

	A	B	C	D	E	F	G	H	I	J	K	L	M
1													
2	6		5		4		3		2		1		
3													
4	7		8		9		10		11		12		
5													
6	18		17		16		15		14		13		
7													
8	19		20		21		22		23		24		
9													
10	30		29		28		27		26		25		
11													
12	31		32		33		34		35		36		
13													

NOTE: Not more than 2 corners, all in the same town and range, may be recorded on this certificate.

A. Description of original monument and accessories and/or subsequent restoration:

Original corner established by Austin Burt on 9/20/1848. Original bearing trees:

Y. Birch 12" S.77 W. 27 links (17.82')
Y. Birch 14" N.41 E. 15 links (9.90')

Clarence Haight, cruiser, on 5/20/35 recovered a scribed Y. Birch B.T. laying 15 ft. NE from a Maple stake. He placed a location Poster on the NW side of an 8" Maple from which the Maple stake lay N.55° W. 10 ft.

B. Description of corner evidence found and/or method applied in restoring or reestablishing corner:

I restored the corner position at record bearing and distance from the remains of the two original bearing trees. The first one is a series of root holes with fragments of Yellow Birch bark. The second one is now a downed 20-26" Yellow Birch with both GLO blazes and axe marks still visible.

Haight's tag tree is now a cut 17" Sugar Maple bearing S.48° E., 10.5 ft. from the original corner position.


Corner research on file with Gogebic County records.

C. Description of monument for corner and accessories established to perpetuate locating the position of the corner:

At the corner position I set a 30" long aluminum pipe with a 3 ¼" stamped aluminum cap and the following new blazed and scribed Bearing trees: (distances taken to a 10p nail in the side of the B.T.)

Sugar Maple 12" N.81° W. 17.23'
Red Maple 7" N.54° E. 20.76'
Hemlock 15" S.41° E. 15.18'
Steel sign rail 6' N.05° W. 2.05'

Richard L. Drahn 9/27/00

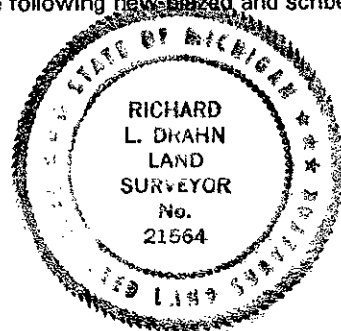

Signed by Richard L. Drahn Date September 23, 2000

Surveyor's Michigan License No. 21564

FORM APPROVED BY MICHIGAN STATE BOARD OF PROFESSIONAL SURVEYORS, JAN. 28, 1971

REVISED MAY 14, 1975

REVISED JAN., 1993
REVISED OCT., 1995