

LAND CORNER RECORDATION CERTIFICATE
Filing Requirement of Act 74, Mich. P.A. 1970

Register's Office }
 Gogebic County }

Received for record the
25th day of AUGUST
 A. D. 2000 at 1:20 o'clock
P. M., and recorded in
 Liber 8 of CORNERS
 at page 23
Ramona Collins, Deputy
 Register of Deeds

For corners in

Gogebic
 (County)

Located In:

Corner Code #

1. Public Land Survey

T 48N R 45W K-2

T ___ R ___

T ___ R ___

T ___ R ___

2. Property Controlling
 in Section

S ___ T ___ R ___

S ___ T ___ R ___

3. Miscellaneous
 Property in Sec.

S ___ T ___ R ___

S ___ T ___ R ___

**SURVEY &
 MONUMENTATION**

JAN 05 2001

Register of Deeds Stamp & File Number

4. Lot No. _____, Recorded Plat _____ SECTION _____
 5. Private Claims _____

$\frac{1}{4}$ Corner 1 & 2; T.48 N., R.45 W.


I, Richard L. Drahn in a field survey on Aug. 18, 2000 do hereby state that under requirements of P.A. 74, Michigan P.A. of 1970, the corner points mentioned in lines 1 and 2 above were in conformance with regulations and rules therefore as required in the current manual of survey instructions of the United States Department of the Interior, Bureau of Land Management or by a decree of a Court of Law and /or that the corner points mentioned in lines 3, 4 and 5 above were in conformance with the rules of the Michigan Board of Land Surveyors or by a Decree of a Court of Law; established, re-established, monumented, recovered, found as expressed below.

NOTE: Not more than 2 corners, all in the same town and range, may be recorded on this certificate.

	A	B	C	D	E	F	G	H	I	J	K	L	M
1													
2	6		5		4		3		2		1		
3													
4	7		8		9		10		11		12		
5													
6	18		17		16		15		14		13		
7													
8	19		20		21		22		23		24		
9													
10	30		29		28		27		26		25		
11													
12	31		32		33		34		35		36		
13													

A. Description of original monument and accessories and/or subsequent restoration:

Original corner established by Austin Burt on 9/18/1848. Original B
 Sugar 10" S.61 W. 26 links (17.16')
 Lynn 18" N.72 E. 17 links (11.22')

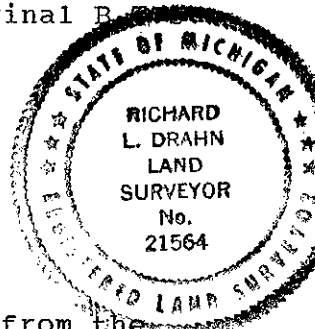

B. Description of corner evidence found and/or method applied in restoring or reestablishing corner:

I restored the corner position at record bearing and distance from the stump hole of the original Sugar Maple bearing tree. The location of the Lynn bearing tree is on the southerly edge of an old logging road and has been destroyed by construction. The distances north and south to recovered section corners is in accord with the field notes of the original Government survey.

A 4" squared Cedar picket and a 3/4" iron pipe set by the Gogebic County Forestry Comm. bears S.33 W., 13.37' from the original corner position.

Corner research on file with Gogebic County Records.

C. Description of monument for corner and accessories established to perpetuate locating the position of the corner:

At the corner position I set a 30" X 2" aluminum pipe with a 3 1/4" stamped aluminum cap and the following new bearing trees:

Sugar Maple	7"	N.72 W.	10.69'
Sugar Maple	7"	N.31 E.	3.87'
Sugar Maple	15"	S.12 W.	17.87'
Steel sign rail	6'	N.44 W.	2.00'

Richard L. Drahn 8/23/00
 GOGEBIC COUNTY REGISTERED LAND SURVEYOR

Signed by Richard L. Drahn
 Surveyor's Michigan License No. 21564

Date August 19, 2000