

MAR 02 2000

SECTION

LAND CORNER RECORDATION CERTIFICATE
Filing Requirement of Act 74, Mich. P.A. 1970

Register's Office
Gogebic County

Received for record the
26TH day of AUGUST
A. D. 1999 at 1:45 o'clock
P. M., and recorded in
Liber 7 of CORNERS

on page 236
Ramona Collins, Deputy
Register of Deeds

For corners in

<u>Gogebic</u> (County)	Located In:	Corner Code #
1. Public Land Survey	<u>T 48 N R 45 W.</u>	<u>M-1</u>
	<u>T 49 N R 45 W</u>	<u>M-13</u>
	<u>T 48 N R 44 W</u>	<u>A-1</u>
	<u>T 49 N R 44 W</u>	<u>Ontonagon County</u>
2. Property Controlling in Section	S ___ T ___ R ___	___
	S ___ T ___ R ___	___
3. Miscellaneous Property in Sec.	S ___ T ___ R ___	___
	S ___ T ___ R ___	___

Register of Deeds Stamp & File Number

4. Lot No. _____, Recorded Plat _____
5. Private Claims _____

Township corner 1, 6, 31 & 36; T.48-49 N., R.44-45 W.

I, Richard L. Drahn, in a field survey on July 30, 1999 do hereby state that under requirements of P.A. 74, Michigan P.A. of 1970, the corner points mentioned in lines 1 and 2 above were in conformance with regulations and rules therefore as required in the current manual of survey instructions of the United States Department of the Interior, Bureau of Land Management or by a decree of a Court of Law and /or that the corner points mentioned in lines 3, 4 and 5 above were in conformance with the rules of the Michigan Board of Land Surveyors or by a Decree of a Court of Law; established, re-established, monumented, recovered, found as expressed below:

NOTE: Not more than 2 corners, all in the same town and range, may be recorded on this certificate.

1	A	B	C	D	E	F	G	H	I	J	K	L	M
2		6		5		4		3		2		1	
3													
4		7		8		9		10		11		12	
5													
6		18		17		16		15		14		13	
7													
8		19		20		21		22		23		24	
9													
10		30		29		28		27		26		25	
11													
12		31		32		33		34		35		36	
13													

A. Description of original monument and accessories and/or subsequent restoration:

Original corner established by Austin Burt on 8/18/1847. Original bearing trees:
Hemlock 16" S.37° E. 22 links (14.52')
Tamarack 14" N.18° W. 31 links (20.46')

O. C. Schoenfeld, timber cruiser, on 4/25/35, recovered the Tamarack B.T. still scribed and placed a Location Poster on the south side of a 12" Pine, 10 links south of the B.T.

B. Description of corner evidence found and/or method applied in restoring or reestablishing corner:

Original corner location found marked by portions of a 2" X 2' picket at record bearing and distance from the remains of the two original bearing trees. The first is 18" Tamarack windfall under 10" of swamp litter. The second one is now a large windthrown stump hole.

Recovered Schoenfeld's location poster on the south side of a 13" White Pine stub, 6 1/2' south of the original Tamarack B.T. and N.26° W., 15.3' from the original corner location.

A 1" X 3' iron pipe and Cedar post bears S.13° E., 73.6'.


Corner research on file with Gogebic County records.

C. Description of monument for corner and accessories established to perpetuate locating the position of the corner:

At the corner position I set a 3/4 X 4' aluminum rod monument with a 3 1/4" stamped aluminum cap and the following new B.T.s (all measurements taken to a nail in side of tree)

Cedar	8"	N.58° E.	21.91'
Hemlock	10"	S.79° W.	44.32'
Cedar	8"	S.18° E.	8.60'
Steel sign rail	6'	N.16° W.	1.74'

DEED GROUP APPROVED
Richard L. Drahn 8/24/99
COUNTY REPRESENTATIVE

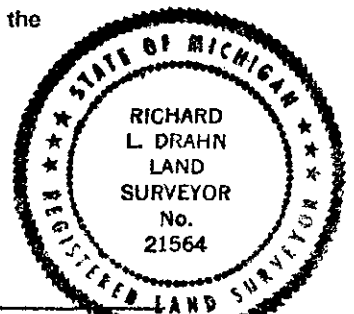

Signed by Richard L. Drahn Date August 10, 1999

Surveyor's Michigan License No. 21564

FORM APPROVED BY MICHIGAN STATE BOARD OF PROFESSIONAL SURVEYORS, JAN. 29, 1971
REVISED MAY 14, 1976
REVISED JAN., 1983
REVISED OCT., 1998