

MAR 02 2000

SECTION

LAND CORNER RECORDATION CERTIFICATE
Filing Requirement of Act 74, Mich. P.A. 1970

Register's Office }
Gogebic County } ss.

For corners in

<u>Gogebic</u> (County)	Located In:	Corner Code #
1. Public Land Survey	<u>T 48N R 45W.</u>	<u>M-9</u>
	<u>T R</u>	
	<u>T R</u>	
	<u>T48N R 44W</u>	<u>A-9</u>
2. Property Controlling in Section	S <u>T R</u>	
	S <u>T R</u>	
3. Miscellaneous Property in Sec.	S <u>T R</u>	
	S <u>T R</u>	

Received for record the
22nd day of OCTOBER
A. D. 1999 at 11:20 o'clock
A m., and recorded in
Liber 7 of CORNERS
on page 257

Ramona Collins Deputy
Register of Deeds

Register of Deeds Stamp & File Number

4. Lot No. _____, Recorded Plat _____
5. Private Claims _____

Section Corner 24, 25, 19 & 30; T.48 N., R.44-45 W.

I, Richard L. Drahn, in a field survey on September 27, 1999 do hereby state that under requirements of P.A. 74, Michigan P.A. of 1970, the corner points mentioned in lines 1 and 2 above were in conformance with regulations and rules therefore as required in the current manual of survey instructions of the United States Department of the Interior, Bureau of Land Management or by a decree of a Court of Law and /or that the corner points mentioned in lines 3, 4 and 5 above were in conformance with the rules of the Michigan Board of Land Surveyors or by a Decree of a Court of Law; established, re-established, monumented, recovered, found as expressed below:

NOTE: Not more than 2 corners, all in the same town and range, may be recorded on this certificate.

A. Description of original monument and accessories and/or subsequent restoration:

Original corner established by Austin Burt on 9/8/1847. Original bearing trees:

Cedar	8"	S.23° E.	14 links	(9.24')
Black Ash	8"	N.48° W.	18 links	(11.88')

Donald D. Lappala, RLS 12585, restored the corner on 8/29/72, from the remains of the two original bearing tree stumps. The Black Ash B.T. was still scribed. He set a 2" X 5" iron pipe with a 3" stamped brass cap and the following new B.T.s:

Cedar	4"	N.87° W.	17.0'
Ash	12"	N.45° E.	27.0'
Ash	14"	S.01° E.	22.7'
Metal sign post	--	S.43° E.	1.3'

Corner recorded in Gogebic County in USFS Liber, Page R-1 on 12/9/74.

B. Description of corner evidence found and/or method applied in restoring or reestablishing corner:

I recovered the monument as described and the subsequent B.T.s as follows:

Cedar	6"	N.86° W.	16.99	(new nail)
Black Ash (dead)	12"	N.47° E.	27.41'	(new nail)
B. Ash (downed)	14"	S.01° W.	22.3'	
B. Ash (downed)	16"	S.29° W.	30.6'	
Steel sign rail	6'	S.43° E.	1.42'	

Positions of the original Cedar and B. Ash B.T. stumps are still identifiable.

Corner research on file with Gogebic County records.


C. Description of monument for corner and accessories established to perpetuate locating the position of the corner:

From the previously described monument I established the following new bearing trees:

Black Ash	7"	N.74° E.	33.69'
Red Maple	5"	S.11° W.	15.89'

DEER GROUP APPROVED

Richard L. Drahn 10/01/99
COUNTY REGISTER

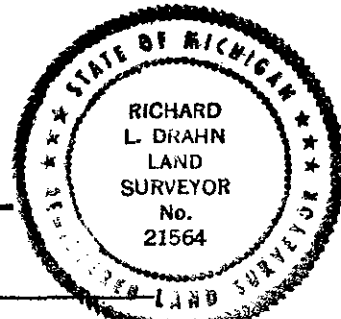

Signed by Richard L. Drahn Date October 2, 1999

Surveyor's Michigan License No. 21564

FORM APPROVED BY MICHIGAN STATE BOARD OF PROFESSIONAL SURVEYORS, JAN. 28, 1971
REVISED MAY 14, 1976
REVISED JAN., 1983
REVISED OCT., 1986