

SURVEY & REMONUMENTATION

SEP 08 1998

LAND CORNER RECORDATION CERTIFICATE
 Filing Requirement of Act 74, Mich. P.A. 1970

Register's Office }
 Gogebic County } SS.

Received for record the
20th day of AUGUST
 A. D. 1998 at 1:20 o'clock
P m., and recorded in
 Liber 7 of CORNERS

on page 50
Ramona L. Collins Deputy
 Register of Deeds

Register of Deeds Stamp & File Number

SECTION
 For corners in

<u>Gogebic</u> (County)	Located In:	Corner Code #
1. Public Land Survey	T48N R 45W	C-12
	T ___ R ___	_____
	T ___ R ___	_____
	T ___ R ___	_____
2. Property Controlling in Section	S ___ T ___ R ___	<u>seg. 2</u>
	S ___ T ___ R ___	_____
3. Miscellaneous Property in Sec.	S ___ T ___ R ___	_____
	S ___ T ___ R ___	_____

4. Lot No. _____, Recorded Plat _____
 5. Private Claims _____

Quarter corner 31 & 32: T.48 N., R.45 W.

Richard L. Drahn, in a field survey on August 13, 19 98, do hereby certify that under requirements of P.A. 74, Michigan P.A. of 1970, the corner points mentioned in lines 1 and 2 above were in conformance with regulations and rules therefore as required in the current manual of survey instructions of the United States Department of the Interior, Bureau of Land Management or by a decree of a Court of Law and/or that the corner points mentioned in lines 3, 4 and 5 above were in conformance with the rules of the Michigan Board of Land Surveyors or by a Decree of a Court of Law; established, re-established, monumented, re-monumented, recovered, found as expressed below:

A	B	C	D	E	F	G	H	I	J	K	L	M
2	6	5	4	3	2	1						
3												
4	7	8	9	10	11	12						
5												
6	18	17	16	15	14	13						
7												
8	19	20	21	22	23	24						
9												
10	30	29	28	27	26	25						
11												
12	31	● 32	33	34	35	36						
13												

NOTE: Not more than 4 corners, all in the same town and range, may be recorded on this certificate.

A. Description of original monument and accessories and/or subsequent restoration:

Original Corner established by Austin Burt on 9/27/1848. Original B.T.s--- Cedar 8" S.65 W. 18 links (11.88') --- Cedar 12" N.52 E. 27 links (17.82')---
 Corner position re-established by Richard L. Drahn, RLS 21564 on 5/15/95 by single proportionate methods. He set a 2½" X 30" alum. pipe with a 3¼" stamped aluminum cap and the following new B.T.s:
 4" Elm N.40 W. 48.14'
 7" Aspen N.60 E. 85.35'
 3" Ash S.39 W. 14.79'
 6' Steel guard rail S.16 W. 0.96'

B. Description of corner evidence found and/or method applied in restoring or reestablishing corner:


Corner recorded in Gogebic County Liber 5, Page 338 on 3/28/96.
 Monument and Steel guard rail have been destroyed by road re-construction.
 Recovered the 1995 new bearing trees as follows:
 4" Elm N.40 W. 48.14'
 8" Aspen N.60 E. 85.35'
 4" Black Ash S.39 W. 14.79'

No evidence remains of the original B.T.s.

PEER GROUP APPROVED
Richard L. Drahn 8/19/98
 COUNTY REGISTERED SURVEYOR

C. Description of monument for corner and accessories established to perpetuate locating the position of the corner:

At the site of the 1995 Monument I set a 2" X 18" long aluminum pipe with a 3½" stamped aluminum cap 8" below the southerly shoulder of Planters RD.
 New bearing object referenced:
 6' Steel guard rail S.05 E. 8.05'

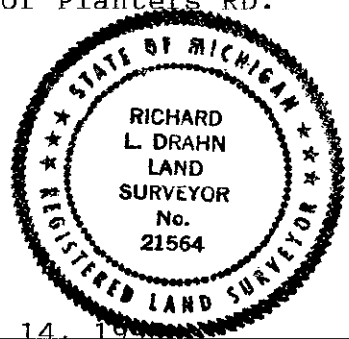

Signed by Richard L. Drahn Date August 14, 1998
 Surveyor's Michigan License No. 21564