

LAND CORNER RECORDATION CERTIFICATE
Filing Requirement of Act 74, Mich. P.A. 1970

Register's Office }
 Gogebic County } ss.

Received for record the
19th day of AUGUST
 A. D. 1994 at 1:10 o'clock
P m., and recorded in
 Liber 5 of CORNERS
 on page 74
Ramona Collins, Deputy
 Register of Deeds

Register of Deeds Stamp & File Number

For corners in

Gogebic
 (County)

Located In:

Corner Code #

1. Public Land Survey	T	<u>47N</u>	R	<u>47W</u>	<u>M-1</u>
<u>S-1</u>	T		R		
	T	<u>47N</u>	R	<u>46W</u>	<u>A-1</u>
	T		R		
2. Property Controlling	S	<u>48N</u>	R	<u>47W</u>	<u>M-13</u>
in Section	S		R		
3. Miscellaneous	S	<u>48N</u>	R	<u>46W</u>	<u>A-13</u>
Property in Sec.	S		R		

4. Lot No. _____, Recorded Plat _____
 5. Private Claims _____

I, John R. Garske, in a field survey on May 5, 1994, do hereby certify that under requirements of P.A. 74, Michigan P.A. of 1970, the corner points mentioned in lines 1 and 2 above were in conformance with regulations and rules therefore as required in the current manual of survey instructions of the United States Department of the Interior, Bureau of Land Management or by a decree of a Court of Law and/or that the corner points mentioned in lines 3, 4 and 5 above were in conformance with the rules of the Michigan Board of Land Surveyors or by a Decree of a Court of Law; established, re-established, monumented, re-monumented, recovered, found as expressed below:

NOTE: Not more than 4 corners, all in the same town and range, may be recorded on this certificate.

A	B	C	D	E	F	G	H	I	J	K	L	M
2	6	5	4	3	2	1						
3												
4	7	8	9	10	11	12						
5												
6	18	17	16	15	14	13						
7												
8	19	20	21	22	23	24						
9												
10	30	29	28	27	26	25						
11												
12	31	32	33	34	35	36						
13												

A. Description of original monument and accessories and/or subsequent restoration:

Original survey by William Austin Burt, D.S., in 1847. Original Bearing Trees:

Hemlock 8" - N48°E - 34 links
 Sugar 9" - N50°W - 14 links

The corner position was established by Ewart C. Muller, RLS 15408, in December of 1977 and recorded in Liber 1 of Land Corners on Page 339.

Accessories: 4" maple - N20°W-15.69'; 8" Y. birch - Due West - 28.58'; 6" maple - S25°E - 9.32'; twin 6" elm - N31°E - 50.07'.

B. Description of corner evidence found and/or method applied in restoring or reestablishing corner:

I found a 1" iron pipe marking the corner position which checks with Mullers certificate. I remonumented the corner position and upgraded accessories as noted below to state and county specifications.

Act 74 research on file with County Register of Deeds Office.

PEER GROUP


Approved

Richard L. Drahm 8/17/94

C. Description of monument for corner and accessories established to perpetuate locating the position of the corner:

Replaced 1" iron pipe with a 2 1/2" diameter x 30" long aluminum pipe with a 3 1/4" aluminum cap stamped to note the corner position, from which I established the following bearing objects:

Steel sign post - N85°E - 1.63 feet
 4" sugar - N20°W - 16.00 feet
 8" Y. birch - Due West - 29.20 feet
 6" sugar - S25°E - 9.53 feet

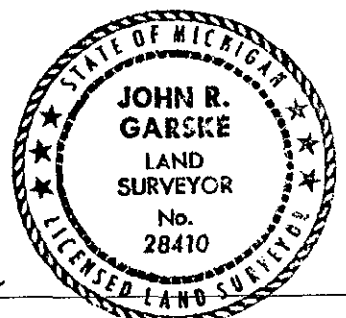

Signed by John R. Garske Date 6/10/94

Surveyor's Michigan License No. 28410