

MAR 02 2000

SECTION

LAND CORNER RECORDATION CERTIFICATE  
Filing Requirement of Act 74, Mich. P.A. 1970

Register's Office }  
Gogebic County } ss.

For corners in

Gogebic

(County)

Located In:

Corner Code #

1. Public Land Survey

T48N R46W

D-5

T R

T R

T R

2. Property Controlling  
in Section

S

T R

S

T R

3. Miscellaneous  
Property in Sec.

S

T R

S

T R

Received for record the  
10<sup>th</sup> day of NOVEMBER  
A. D. 1999 at 11:25 o'clock  
A m., and recorded in  
Liber 7 of CORNERS  
on page 274  
Ramona Collins, Deputy  
Register of Deeds

Register of Deeds Stamp & File Number


4. Lot No. \_\_\_\_\_, Recorded Plat \_\_\_\_\_

5. Private Claims \_\_\_\_\_

Quarter Section Corner Sections 8 & 17, T48N, R46W

I, John P. Goss, in a field survey on Oct. 21, 1999 do hereby state that under requirements of P.A. 74, Michigan P.A. of 1970, the corner points mentioned in lines 1 and 2 above were in conformance with regulations and rules therefore as required in the current manual of survey instructions of the United States Department of the Interior, Bureau of Land Management or by a decree of a Court of Law and/or that the corner points mentioned in lines 3, 4 and 5 above were in conformance with the rules of the Michigan Board of Land Surveyors or by a Decree of a Court of Law, established, re-established, monumented, recovered, found as expressed below:

NOTE: Not more than 2 corners, all in the same town and range, may be recorded on this certificate.

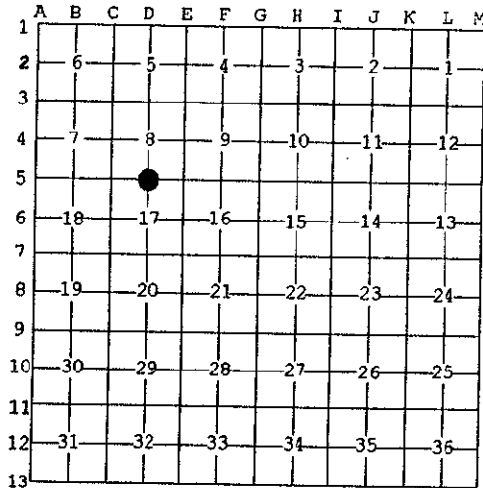

A. Description of original monument and accessories and/or subsequent restoration:

Corner established by Austin Burt, on June 4, 1851. Section Corner Hemlock 16"  
Original Bearing tree: Sugar 14" S 25° W 16 links (10.56 ft.)

B. Description of corner evidence found and/or method applied in restoring or reestablishing corner:

I recovered the Hemlock it now is a 28" to 30" badly decayed stump, also there is a stump hole at location of bearing tree. This location check with the Gogebic County Road Comm. 1924 plans of Black River Road to the West and the creek call to the East, per GLO notes.

Corner research on file with Gogebic County records.

PEER GROUP APPROVED  
Richard P. Drahm 11/9/99  
COUNTY SURVEYOR

C. Description of monument for corner and accessories established to perpetuate locating the position of the corner:

In the Center of the badly decayed stump I place a 3/4" by 48" aluminum march rod with a 3 1/2" aluminum cap, stamped to read: County Remonumentation; T.48 N., R.46 W.; 1/4; S-8, S-17; 1999; P.S. 23509. I established 3 bearing trees and a reference object.

- 15" Maple N 61° W 15.49 ft.
  - 6" Maple N 21° E 17.21 ft.
  - 6" Maple S 23° E 16.27 ft.
  - 6" Rail & Sign S 03° W 1.97 ft. to face
- Distance are to nail in side of tree.



Signed by John P. Goss  
Surveyor's Michigan License No. 23509

Date October 22, 1999

USFS J-7