

**SURVEY &  
REMONUMENTATION**

SEP 08 1998

**LAND CORNER RECORDATION CERTIFICATE**  
Filing Requirement of Act 74, Mich. P.A. 1970

Register's Office }  
Gogebic County } ss.

For corners in SECTION

|                                       |             |               |
|---------------------------------------|-------------|---------------|
| <u>Gogebic</u><br>(County)            | Located In: | Corner Code # |
| 1. Public Land Survey                 | T48NR 46W   | E -7          |
|                                       | T R         |               |
|                                       | T R         |               |
|                                       | T R         |               |
| 2. Property Controlling<br>in Section | S T R       |               |
|                                       | S T R       |               |
| 3. Miscellaneous<br>Property in Sec.  | S T R       |               |
|                                       | S T R       |               |

Received for record the  
14<sup>TH</sup> day of MAY  
A. D. 1998 at 3:30 o'clock  
P m., and recorded in  
Liber 6 of CORNERS  
on page 393  
Ramona Collins, Dep.  
Register of Deeds


Register of Deeds Stamp & File Number

4. Lot No. \_\_\_\_\_, Recorded Plat \_\_\_\_\_  
5. Private Claims \_\_\_\_\_

S.C. comm. to sec's 16, 17, 20 & 21

I, John P. Goss, in a field survey on March 6, 1998 do hereby state that under requirements of P.A. 74, Michigan P.A. of 1970, the corner points mentioned in lines 1 and 2 above were in conformance with regulations and rules therefore as required in the current manual of survey instructions of the United States Department of the Interior, Bureau of Land Management or by a decree of a Court of Law and /or that the corner points mentioned in lines 3, 4 and 5 above were in conformance with the rules of the Michigan Board of Land Surveyors or by a Decree of a Court of Law; established, re-established, monumented, recovered, found as expressed below:

NOTE: Not more than 2 corners, all in the same town and range, may be recorded on this certificate.

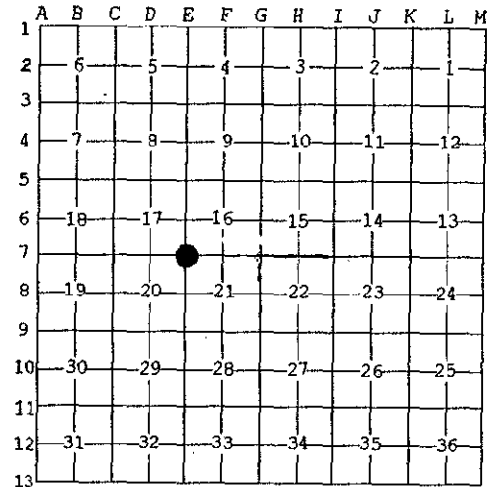

**A. Description of original monument and accessories and/or subsequent restoration:**

Original corner established by Austin Burt on May 31, 1851. Set post.  
Original bearing trees: Yellow Birch S 53° E 30 links  
Hemlock N 53° W 60 links

On June 14, 1977, Richard Drahn, RLS, restored corner position at record bearing and distance from remains of original bearing trees. One a 20" - 26" Y. Birch stump the second is a Hemlock stump hole. He also used natural feature ties. He set a 2½" iron pipe with 3" bronze cap stamped to indicated corner position. He established the following reference objects.

|            |         |       |
|------------|---------|-------|
| 10" Hemloc | N 12° W | 30.4' |
| 5" Cedar   | S 36° E | 39.8' |

**B. Description of corner evidence found and/or method applied in restoring or reestablishing corner:**

|               |         |       |
|---------------|---------|-------|
| 6" Black Ash  | S 68° W | 31.3' |
| 7' Metal Post | S 45° E | 2.0'  |

He recorded said corner in Liber 1, page 371 of Land Corners for Gogebic County.

Found Richard Drahn corner monument and witnesses.

I Updated the corner monument and accessories as noted below to state and county specification.

Act 74 research on file.

**C. Description of monument for corner and accessories established to perpetuate locating the position of the corner:**

From the 2½" iron pipe with 3" bronze cap which read: T.48 N., R.46 W; S-15, S-16, S-21, S-22, R.L.S. 21564; 1977, from which I established the existing and new bearing trees and reference object.


|                          |         |                 |
|--------------------------|---------|-----------------|
| 12" Hemlock              | N 12° W | 30.09'          |
| 8" Cedar                 | S 36° E | 39.86'          |
| 9" Black Ash             | S 72° W | 31.25'          |
| 6" Black Ash             | N 28° E | 18.93'          |
| 7' Metal post<br>& signs | S 45° E | 1.92' (to face) |

(All measurement to nail in side of tree)

Signed by John P. Goss  
Surveyor's Michigan License No. 23509

Date March 6, 1998

**PEER GROUP APPROVAL**  
Richard L. Drahn 5/13/98  
COUNTY REGISTER

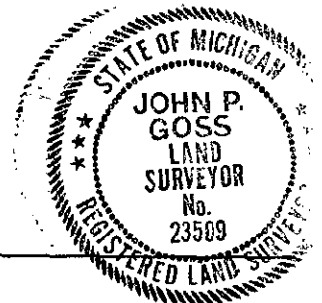

Fed. No. N-9