

MAR 02 2000

SECTION

LAND CORNER RECORDATION CERTIFICATE
Filing Requirement of Act 74, Mich. P.A. 1970

Register's Office }
Gogebic County } ss.

Received for record the
26TH day of AUGUST
A. D. 1999 at 1:45 o'clock
P m., and recorded in
Liber 7 of CORNERS
page 240
Ramona Collins Deputy
Register of Deeds

For corners in

Gogebic
(County)

Located In:

Corner Code #

1. Public Land Survey	T <u>48</u> N	R <u>46</u> W	<u>F-5</u>
	T ___ R ___		
	T ___ R ___		
	T ___ R ___		
2. Property Controlling in Section	S ___ T ___	R ___	
	S ___ T ___	R ___	
3. Miscellaneous Property in Sec.	S ___ T ___	R ___	
	S ___ T ___	R ___	

Register of Deeds Stamp & File Number

4. Lot No. _____, Recorded Plat _____
5. Private Claims _____

1/4 corner sections 9 & 16, T.48 N., R.46 W.

I, John P. Goss, in a field survey on July 27 1999 do hereby state that under requirements of P.A. 74, Michigan P.A. of 1970, the corner points mentioned in lines 1 and 2 above were in conformance with regulations and rules therefore as required in the current manual of survey instructions of the United States Department of the Interior, Bureau of Land Management or by a decree of a Court of Law and/or that the corner points mentioned in lines 3, 4 and 5 above were in conformance with the rules of the Michigan Board of Land Surveyors or by a Decree of a Court of Law; established, re-established, monumented, recovered, found as expressed below:

NOTE: Not more than 2 corners, all in the same town and range, may be recorded on this certificate.

A	B	C	D	E	F	G	H	I	J	K	L	M
1												
2	6	5	4	3	2	1						
3												
4	7	8	9	10	11	12						
5												
6	18	17	16	15	14	13						
7												
8	19	20	21	22	23	24						
9												
10	30	29	28	27	26	25						
11												
12	31	32	33	34	35	36						
13												

A. Description of original monument and accessories and/or subsequent restoration:

Corner established by Austin Burt, on June 4, 1851, set post.
Original bearing trees:

Y. Birch 16" S 18° W 35 links (23.1')
Y. Birch 14" N 24° E 20 links (13.2')

DEED GROUP ATTACHED
Richard L. Drahn 8/24/99
COUNTY REGISTER

B. Description of corner evidence found and/or method applied in restoring or reestablishing corner:

Restored corner position at record bearing and distance from the remains of the two original bearing trees. The first is now a 29" Y. Birch N 24° E with the lower blazes rotted out and the second is now a 18" to 20" Y. Birch stump at ground level with a 2" Y. Birch growing out of it side. The 2.95 chain to East leave swamp and 8.8 chain East to stream 25 links, SW, are in accordance with the field notes of the original Government Survey.

5" by 5" Cedar post S 24° W 6.2 feet. by Keweenaw Land Inc.

C. Description of monument for corner and accessories established to perpetuate locating the position of the corner:


At the corner position I set a 2 1/2" by 30" aluminum pipe with a 3 1/4" aluminum cap stamped to read: County Remonumentation; T.48 N., R 46 W.: 1/4; S-9, S-16; 1999; P.S. 23509. I established the following reference objects:

9" Black Ash Due S 24.35 ft.
14" Cedar N 77° E 45.07 ft.
10" Maple N 84° W 37.32 ft.
6' Metal sign N 12° E 1.67 ft. to face post

(All measurement taken to nail in side of tree)

Signed by John P Goss
Surveyor's Michigan License No. 23509

Date July 28, 1999

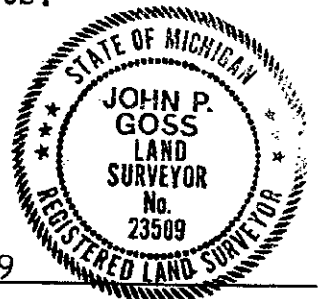

USFS J-11