

SURVEY & REMONUMENTATION

JAN 22 1998

SECTION

LAND CORNER RECORDATION CERTIFICATE
Filing Requirement of Act 74, Mich. P.A. 1970

Register's Office }
Gogebic County } ss.

Received for record the
22ND day of DECEMBER
A. D. 1997 at 11:00 o'clock
11 a. m., and recorded in
Liber 6 of CORNERS
on page 299
Ramona Collins, Deputy
Register of Deeds

For corners in Gogebic (County)	Located In:	Corner Code #
1. Public Land Survey	Section 28 48N 46W	F-9
	T ___ R ___	_____
	T ___ R ___	_____
	T ___ R ___	_____
	T ___ R ___	_____
2. Property Controlling in Section	S ___ T ___ R ___	_____
	S ___ T ___ R ___	_____
3. Miscellaneous Property in Sec.	S ___ T ___ R ___	_____
	S ___ T ___ R ___	_____

Register of Deeds Stamp & File Number

4. Lot No. _____, Recorded Plat _____
5. Private Claims _____

1/4 corner sections 21 & 28, T48N, R46W

I, John R. Garske, in a field survey on December 9, 1997 do hereby state that under requirements of P.A. 74, Michigan P.A. of 1970, the corner points mentioned in lines 1 and 2 above were in conformance with regulations and rules therefore as required in the current manual of survey instructions of the United States Department of the Interior, Bureau of Land Management or by a decree of a Court of Law and/or that the corner points mentioned in lines 3, 4 and 5 above were in conformance with the rules of the Michigan Board of Land Surveyors or by a Decree of a Court of Law, established, re-established, monumented, recovered, found as expressed below:

NOTE: Not more than 2 corners, all in the same town and range, may be recorded on this certificate.

	A	B	C	D	E	F	G	H	I	J	K	L	M
1													
2		6	5	4	3	2	1						
3													
4		7	8	9	10	11	12						
5													
6		18	17	16	15	14	13						
7													
8		19	20	21	22	23	24						
9													
10		30	29	28	27	26	25						
11													
12		31	32	33	34	35	36						
13													

A. Description of original monument and accessories and/or subsequent restoration:


Original Township survey by Austin Burt, Deputy Surveyor in 1851.
He set a wood post from which:
Yellow Birch 18" S78°E 27 links
Hemlock 10" N70°W 16 links

B. Description of corner evidence found and/or method applied in restoring or reestablishing corner:

No original evidence exists. I established the corner at the centerline of Salmi Road and Sapsucker Creek. Corner fell in centerline of creek as per GLO and is 40 feet south of old power line which checks with an old L.S.D.P. map. This location best represents the original corner location and also checks well with fence occupation lines along Salmi Road.

SEER GROUP APPROVED
Richard L. Dredin 12/19/97
COUNTY REPRESENTATIVE

(Research on file)

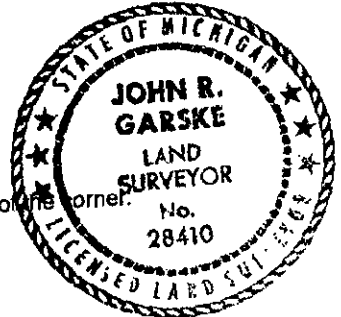

C. Description of monument for corner and accessories established to perpetuate locating the position of the corner:

At the corner position I set a 5/8" x 10" iron rod with a 3 1/4" brass cap stamped to identify the corner, from which:
Reference Monument (R.M.) S37°W 34.20 feet - Steel Sign Rail - 1.00 feet
Power Pole N35°W 50.05 feet
9" Yellow Birch S60°E 37.00 feet
8" Maple N45°W 31.90 feet

Signed by John R. Garske
Surveyor's Michigan License No. 28410

Date 12/19/97