Register's Office } ss.
Gogebic County

Received for record the 16TH day of DECEMBER A. D. 1993 at 2:25 o'clock P m., and recorded in Liber 4 of Corners on page 304.

Betty Sain Deputy
Register of Deeds

Register of Deeds Stamp & File Number

LAND CORNER RECORDATION CERTIFICATE

Filing Requirement of Act 74, Mich. P.A. 1970

For corners in Gogebic (County)

	Located In:	Corner Code ##
1. Public Land Survey Section 4	T47N R 46W	F-1
	T48N R 46W	F-13
	T ___ R ___	
	T ___ R ___	
2. Property Controlling	S ___ T ___ R ___	
in Section	S ___ T ___ R ___	
3. Miscellaneous	S ___ T ___ R ___	
Property in Sec.	S ___ T ___ R ___	

4. Lot No. _____ , Recorded Plat _____
5. Private Claims _____

One-quarter corner S-4 & S-33, T48-47N, R46W.

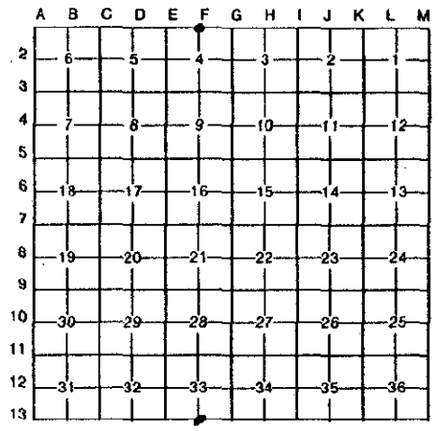

I, John R. Garske, in a field survey on December 2, 19 93, do hereby certify that under requirements of P.A. 74, Michigan P.A. of 1970, the corner points mentioned in lines 1 and 2 above were in conformance with regulations and rules therefore as required in the *current manual of survey instructions of the United States Department of the Interior, Bureau of Land* Management or by a decree of a Court of Law and/or that the corner points mentioned in lines 3, 4 and 5 above were in conformance with the rules of the Michigan Board of Land Surveyors or by a Decree of a Court of Law; established, re-established, monumented, re-monumented, recovered, found as expressed below:

NOTE: Not more than 4 corners, all in the same town and range, may be recorded on this certificate.

A. Description of original monument and accessories and/or subsequent restoration:

Original survey by William A. Burt, U.S.D.S., on September 9, 1847. Set cedar post from which 8" Y. birch bears N60°E, 50 links and a 14" hemlock bears N46°W , 23 links.

No original evidence found.

B. Description of corner evidence found and/or method applied in restoring or reestablishing corner:

No monument found at corner position, however, this position set at fence and road intersection matches with road plans and checks with natural feature ties to the west. Chicago and Northwestern Railroad plans show the corner at this position from 1920's. The corner position was used in a 1990 survey for Great Lakes Gas Company in the subdivision of Section 4. No original evidence of the corner remains today due to road construction. I, therefore, relied on the fences, road and R.R. plans to reestablish the corner.

PEER GROUP APPROVED
Richard L. Drake 4/6/95
COUNTY REPRESENTATIVE

C. Description of monument for corner and accessories established to perpetuate locating the position of the corner:

Set a 3/4" x 24" rebar with 3 1/2" aluminum cap stamped: County Remonumentation; T48N, R46W; S-33; T47N, R46W; S-4; 1993; RLS 28410. Established the following bearing trees and/or reference objects:

12" R. maple - N30°E - 92.65 feet
P. Pole #40 - S56°W - 61.17 feet
6" ash - N72°W - 55.19 feet
Steel sign post - due east - 16.90 feet

Corner is located 22.5 feet east of the curved center line of County Road #513.

STATE OF MICHIGAN
JOHN R. GARSKE
LAND SURVEYOR
No. 28410
LICENSED SURVEYOR

Signed by John R Garske Date 12/9/93

Surveyor's Michigan License No. 28410

FORM APPROVED BY MICHIGAN STATE BOARD OF LAND SURVEYORS, JAN. 28, 1971
REVISED MAY 14, 1975
REVISED JAN., 1983

FED: A-11 304