

SURVEY & REMONUMENTATION

JAN 22 1998

SECTION

LAND CORNER RECORDATION CERTIFICATE Filing Requirement of Act 74, Mich. P.A. 1970

Register's Office }
Gogebic County } ss.

For corners in
Gogebic

Received for record the
22nd day of DECEMBER
A. D. 1997 at 11:00 o'clock
A m., and recorded in
Liber 6 of CORNERS
on page 297
Ramona Owens, Deputy
Register of Deeds

Located In:	Corner Code #
Section 28 48N 46W	G-9
1. Public Land Survey	T ___ R ___
	T ___ R ___
	T ___ R ___
	T ___ R ___
2. Property Controlling in Section	S ___ T ___ R ___
	S ___ T ___ R ___
3. Miscellaneous Property in Sec.	S ___ T ___ R ___
	S ___ T ___ R ___

Register of Deeds Stamp & File Number

4. Lot No. _____, Recorded Plat _____
5. Private Claims _____

Section corner to 21, 22, 27, & 28, T48N, R46W

I, John R. Garske, in a field survey on December 9, 1997 do hereby state that under requirements of P.A. 74, Michigan P.A. of 1970, the corner points mentioned in lines 1 and 2 above were in conformance with regulations and rules therefore as required in the current manual of survey instructions of the United States Department of the Interior, Bureau of Land Management or by a decree of a Court of Law and /or that the corner points mentioned in lines 3, 4 and 5 above were in conformance with the rules of the Michigan Board of Land Surveyors or by a Decree of a Court of Law; established, re-established, monumented, recovered, found as expressed below:

NOTE: Not more than 2 corners, all in the same town and range, may be recorded on this certificate.

	A	B	C	D	E	F	G	H	I	J	K	L	M
1													
2	6		5		4		3		2		1		
3													
4	7		8		9		10		11		12		
5													
6	18		17		16		15		14		13		
7													
8	19		20		21		22		23		24		
9													
10	30		29		28		27		26		25		
11													
12	31		32		33		34		35		36		
13													

A. Description of original monument and accessories and/or subsequent restoration:

Original Township survey by Austin Burt, Deputy Surveyor in 1851.
He set a wood post from which:
Yellow Birch 30" S39°W 14 links
Hemlock 10" N31°E 29 links

B. Description of corner evidence found and/or method applied in restoring or reestablishing corner:


No original evidence exists. I established the corner at the centerline intersection of N. Moore Road and ancient fence line extended from the east, and 30 feet south of a power line which checks with an old L.S.D.P. map distances to existing fence lines at "40" lines north and south along N. Moore Road. checks well with this location. This position is the most logical location for the section corner.
South - 1330± to fence, 2661.00' to 1/4 corner 27 & 28.
North - 1320± to fence, 2648' to 1/4 corner 21 & 22.

C. Description of monument for corner and accessories established to perpetuate locating the position of the corner:

(Research on file)

PEER GROUP APPROVED

Richard L. Draker 12/19/97
COUNTY REPRESENTATIVE

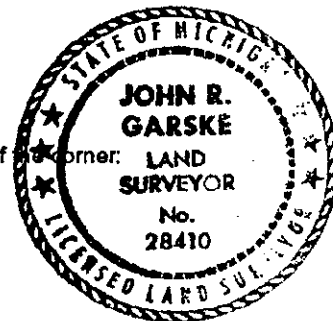

At the corner position I set a 5/8" x 10" iron rod with a 3 1/4" brass cap stamped to identify the corner, from which:
Reference Monument (R.M.) S64°W 31.72 feet - Steel Sign Rail - 1.32 feet
5" Elm Due East 31.02 feet
6" Ash S29°E 61.69 feet
Power pole N44°W 40.66 feet

Signed by John R. Garske
Surveyor's Michigan License No. 28410

Date 12/19/97