

SURVEY & REMONUMENTATION

JAN 22 1998

SECTION

LAND CORNER RECORDATION CERTIFICATE
Filing Requirement of Act 74, Mich. P.A. 1970

For corners in
Gogebic

Register's Office }
Gogebic County } ss.

Received for record the
22ND day of DECEMBER
A. D. 1997 at 11:00 o'clock
A m., and recorded in
Liber 6 of CORNERS
on page 296
Armona Collins, Deputy
Register of Deeds

Located In:	Corner Code #
Section 28 48N 46W	G-10
1. Public Land Survey T ___ R ___ T ___ R ___ T ___ R ___ T ___ R ___	_____
2. Property Controlling in Section S ___ T ___ R ___ S ___ T ___ R ___	_____
3. Miscellaneous Property in Sec. S ___ T ___ R ___ S ___ T ___ R ___	_____

Register of Deeds Stamp & File Number

4. Lot No. _____, Recorded Plat _____
5. Private Claims _____

1/4 corner sections 27 & 28, T48N, R46W

I, John R. Garske, in a field survey on December 3, 19 97 do hereby state that under requirements of P.A. 74, Michigan P.A. of 1970, the corner points mentioned in lines 1 and 2 above were in conformance with regulations and rules therefore as required in the current manual of survey instructions of the United States Department of the Interior, Bureau of Land Management or by a decree of a Court of Law and /or that the corner points mentioned in lines 3, 4 and 5 above were in conformance with the rules of the Michigan Board of Land Surveyors or by a Decree of a Court of Law; established, re-established, monumented, recovered, found as expressed below:

NOTE: Not more than 2 corners, all in the same town and range, may be recorded on this certificate.

	A	B	C	D	E	F	G	H	I	J	K	L	M
1													
2	6		5		4		3		2		1		
3													
4	7		8		9		10		11		12		
5													
6	18		17		16		15		14		13		
7													
8	19		20		21		22		23		24		
9													
10	30		29		28		27		26		25		
11													
12	31		32		33		34		35		36		
13													


A. Description of original monument and accessories and/or subsequent restoration:

Original Township survey by Austin Burt, D.S. in 1851
He set a wood post from which:
Hemlock 12" S78°W 50 links
Hemlock 7" East 34 links

B. Description of corner evidence found and/or method applied in restoring or reestablishing corner:

No original evidence exists. I established the corner at the centerline of N. Moore Road and a fence line extended from the east. Distance checks close to GLO call to a creek south of corner position and distance checks close to existing fence at "40" lines north and south of the corner. This corner position is the most logical position for the 1/4 corner.
North - 1330 to fence, 2661.00 to section corner 21,22,27 & 28.
South - 1310 to fence, 2620.15 to section corner 27, 28 33 & 34.

PEER GROUP APPROVED
Richard L. Drabn 12/19/97
COUNTY REPRESENTATIVE

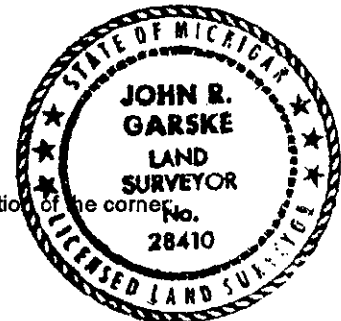

C. Description of monument for corner and accessories established to perpetuate locating the position of the corner:

At the corner position I set a 5/8" x 10" iron rod with a 3 1/4" brass cap stamped to identify the corner, from which:
Reference Monument (R.M.) S58°W 34.44 feet Steel Sign Rail - 1.32 feet
(R.M. - 2 1/2" x 30" long alum. pipe with 3 1/4" dia. alum. cap)
9" Hemlock N75°W 31.37 feet
4" Twin Red Maple S61°E 47.65 feet
3" Spruce N66°E 48.85 feet

Signed by John R. Garske
Surveyor's Michigan License No. 28410

Date 12/19/97