

**SURVEY &
REMONUMENTATION**

FEB 18 1994

COMMISSION

**LAND CORNER RECORDATION CERTIFICATE
Filing Requirement of Act 74, Mich. P.A. 1970**

For corners in

Gogebic
(County)

Located In:

Corner Code #

- | | | |
|------------------------------------|---------------------------|-------------|
| 1. Public Land Survey | T <u>48N</u> R <u>46W</u> | <u>G-12</u> |
| | T _____ R _____ | _____ |
| | T _____ R _____ | _____ |
| | T _____ R _____ | _____ |
| 2. Property Controlling in Section | S _____ T _____ R _____ | _____ |
| | S _____ T _____ R _____ | _____ |
| 3. Miscellaneous Property in Sec. | S _____ T _____ R _____ | _____ |
| | S _____ T _____ R _____ | _____ |

4. Lot No. _____, Recorded Plat _____

5. Private Claims _____

One-quarter corner S-33 & 34, T48N, R46W.

December 13 1993

I, John R. Garske, in a field survey on _____, 19_____, do hereby certify that under requirements of P.A. 74, Michigan P.A. of 1970, the corner points mentioned in lines 1 and 2 above were in conformance with regulations and rules therefore as required in the current manual of survey instructions of the United States Department of the Interior, Bureau of Land Management or by a decree of a Court of Law and/or that the corner points mentioned in lines 3, 4 and 5 above were in conformance with the rules of the Michigan Board of Land Surveyors or by a Decree of a Court of Law; established, re-established, monumented, re-monumented, recovered, found as expressed below:


NOTE: Not more than 4 corners, all in the same town and range, may be recorded on this certificate.

A. Description of original monument and accessories and/or subsequent restoration:

Survey by Austin Burt, U.S.D.S, on 1851. Set wood post at 40.12 chains from which a 14" Y. birch bears S65°W, 14 links and a 16" hemlock bears N72°W, 48 links.

B. Description of corner evidence found and/or method applied in restoring or reestablishing corner:

No original evidence found due to road and utility construction. Set corner by single proportional measurement on line and midway between section corners in accordance with the original survey notes.

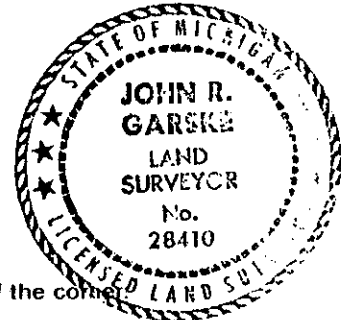

C. Description of monument for corner and accessories established to perpetuate locating the position of the corner:
Set 3/4" x 30" rebar with a 3 1/2" aluminum cap stamped: County Remonumentation; T48N, R46W; 1/4 cor.; S-33; 1993; RLS 28410. Established the following bearing trees and reference objects:

- 6" basswood - S30°E - 82.39 feet
- 8" twin sugar - S58°W - 86.10 feet
- 6" twin red maple - N68°W - 75.68 feet
- 3/4" x 30" aluminum capped rebar - reference monument - N53°E - 40.44 feet with steel sign post - 2.25 feet
- Reference monument - Set a 2 1/2" x 30" Bernstein aluminum monument with a 3 1/2" stamped aluminum cap - south - 78.00 feet - Steel sign post - 1.09 feet
- 27.5 feet west to center line of North Moore Road

Signed by John R Garske Date 12/21/93

Surveyor's Michigan License No. 28410

Register's Office }
Gogebic County } ss.

Received for record the
30th day of DECEMBER
A. D. 1993 at 12:30 o'clock
P m., and recorded in
Liber 4 of CORNERS
on page 336

Betty Swain Deputy
Register of Deeds

Register of Deeds Stamp & File Number

	A	B	C	D	E	F	G	H	I	J	K	L	M
2	6	5	4	3	2	1							
3													
4	7	8	9	10	11	12							
5													
6	18	17	16	15	14	13							
7													
8	19	20	21	22	23	24							
9													
10	30	29	28	27	26	25							
11													
12	31	32	33	34	35	36							
13													