

MAR 02 2000

SECTION

LAND CORNER RECORDATION CERTIFICATE
Filing Requirement of Act 74, Mich. P.A. 1970

Register's Office }
Gogebic County } ss.

Received for record the
26th day of AUGUST
A. D. 1999 at 1:45 o'clock
P m., and recorded in
Liber 7 of CORNERS
on page 242
Ramona Collins Deputy
Register of Deeds

For corners in

Gogebic
(County)

Located In:

Corner Code #

- 1. Public Land Survey T48N R46W H-5
T___ R___
T___ R___
T___ R___
- 2. Property Controlling S___ T___ R___
in Section S___ T___ R___
- 3. Miscellaneous S___ T___ R___
Property in Sec. S___ T___ R___


Register of Deeds Stamp & File Number

- 4. Lot No. _____, Recorded Plat _____
- 5. Private Claims _____

1/4 corner 10 and 15, T48N, R46W

I, John P. Goss, in a field survey on July 20, 1999 do hereby state that under requirements of P.A. 74, Michigan P.A. of 1970, the corner points mentioned in lines 1 and 2 above were in conformance with regulations and rules therefore as required in the current manual of survey instructions of the United States Department of the Interior, Bureau of Land Management or by a decree of a Court of Law and/or that the corner points mentioned in lines 3, 4 and 5 above were in conformance with the rules of the Michigan Board of Land Surveyors or by a Decree of a Court of Law; established, re-established, monumented, recovered, found as expressed below:

NOTE: Not more than 2 corners, all in the same town and range, may be recorded on this certificate.

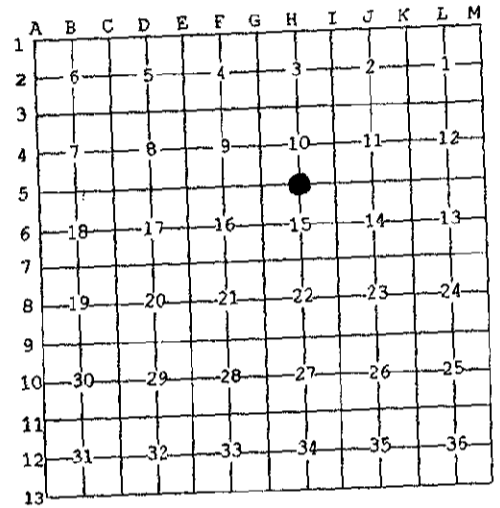

A. Description of original monument and accessories and/or subsequent restoration:

Corner established by Austin Burt, on June 4, 1851.
Original bearing trees: Hemlock 18" N 56° W 32 links (21.12 ft.)
Y. Birch 14" N 10° E 14 links (9.24 ft.)

On October 16, 1979, Richard L. Drahn, RLS, restored corner position at record bearing and distance from the remains of the original bearing trees. He set a 2" iron pipe with 3" brass tablet, stamped to indicated the corner position. He established the following reference objects: 6" Red Maple - N 23° E - 26.6 ft.; 6" Yellow Birch - N 88° E - 20.15 ft.; 7" Red Maple - S 45° W - 39.25 ft.; 6' Metal sign post - S 28° W - 2.2 ft.

B. Description of corner evidence found and/or method applied in restoring or reestablishing corner:

He recorded said corner in Liber 2, page 31 of Land Corners.

Found Richard L. Drahn, monument and accessories.

Act 74 research on file.

DEED GROUP APPROVED
Richard P. Drahn 8/24/99
COUNTY REGISTER OF DEEDS

C. Description of monument for corner and accessories established to perpetuate locating the position of the corner:
From the found monument I established the following new and existing reference objects:

- 9" Red Maple N 23° E 26.65 ft.
- 6" Yellow Birch N 88° E 20.15 ft.
- 10" Red Maple S 45° W 39.41 ft. new nail
- 15" Balsam S 24° E 15.66 ft.
- 6' Metal sign post S 28° W 2.2 ft. to face

(All measurement to nail in side of tree)



Signed by John P. Goss
Surveyor's Michigan License No. 23509
U.S.F.S. No. J-15

Date July 21, 1999