

MAR 02 2000

SECTION

LAND CORNER RECORDATION CERTIFICATE
Filing Requirement of Act 74, Mich. P.A. 1970

For corners in

<u>Gogebic</u> (County)	Located In:	Corner Code #
1. Public Land Survey	T <u>48</u> N R <u>46</u> W	<u>H-11</u>
	T ___ R ___	_____
	T ___ R ___	_____
	T ___ R ___	_____
2. Property Controlling in Section	S ___ T ___ R ___	_____
	S ___ T ___ R ___	_____
3. Miscellaneous Property in Sec.	S ___ T ___ R ___	_____
	S ___ T ___ R ___	_____

Received for record the
22ND day of OCTOBER
A. D. 1999 at 1:40 o'clock
P m., and recorded in
Liber 7 of CORNERS
on page 258

Ramona Collins Deputy
Register of Deeds

Register of Deeds Stamp & File Number

4. Lot No. _____, Recorded Plat _____
5. Private Claims _____

Quarter corner, sections 27 & 34, T48N, R46W

I, John P. Goss, in a field survey on Oct. 11, 1999 do hereby state that under requirements of P.A. 74, Michigan P.A. of 1970, the corner points mentioned in lines 1 and 2 above were in conformance with regulations and rules therefore as required in the current manual of survey instructions of the United States Department of the Interior, Bureau of Land Management or by a decree of a Court of Law and /or that the corner points mentioned in lines 3, 4 and 5 above were in conformance with the rules of the Michigan Board of Land Surveyors or by a Decree of a Court of Law; established, re-established, monumented, recovered, found as expressed below:

A	B	C	D	E	F	G	H	I	J	K	L	M
1												
2	6		5		4		3		2		1	
3												
4	7		8		9		10		11		12	
5												
6	18		17		16		15		14		13	
7												
8	19		20		21		22		23		24	
9												
10	30		29		28		27		26		25	
11												
12	31		32		33		34		35		36	
13												

NOTE: Not more than 2 corners, all in the same town and range, may be recorded on this certificate.

A. Description of original monument and accessories and/or subsequent restoration:

Corner established by Austin Burt, on May 30, 1851. Set post.

Original bearing trees:

- Fir 12" S 03° E 23 links (15.18 ft.)
- Elm 22" N 02° W 28 links (18.48 ft.)

B. Description of corner evidence found and/or method applied in restoring or reestablishing corner:

No evidence of original B.T.'s found. Corner restored at the intersection of the centerlines of North/South and East/West county road and a fence line to the East and Section corner to the West. At the corner position, buried 4 inch, set a 5/8 inch by 10 inch rebar with a 3/4 inch aluminum cap, stamped to indicated the corner position. I accept the rebar with aluminum cap as the best available evidence for restoring the corner position.


Act 74 research on file.

Richard P. Decker 10/14/99
DEER GROUP APPROVED
COURT RESEARCHER

C. Description of monument for corner and accessories established to perpetuate locating the position of the corner:

From the above described corner position, I set two 2" by 30" aluminum reference monument with 3/4" aluminum cap stamped as follows: County Remonumentation, R.M.; 1/4; S-27, S-34; 1999; P.S. 23509, from which I established the following reference objects:

- Power Pole #27-53/07 N 57° E 58.92 ft.
- Power Pole #34-54/95 S 45° E 60.18 ft.
- R.M. N 52° W 59.13 ft. & Rail 1.03 ft.
- R.M. S 50° W 57.26 ft. & Rail 1.32 ft.

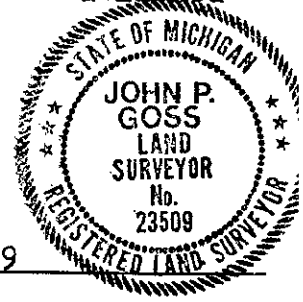

Signed by John P. Goss
Surveyor's Michigan License No. 23509

Date October 11, 1999

USFS V-15