

LAND CORNER RECORDATION CERTIFICATE
Filing Requirement of Act 74, Mich. P.A. 1970

Register's Office }
 Gogebic County } ss.

For corners in

Gogebic County Located in: _____ Corner Code # _____

1. Public Land Survey T 48 N R 46 W 1-12
 T _____ R _____
 T _____ R SURVEY &
 T _____ R MONUMENTATION
 2. Property Controlling S _____ T _____ R _____
 in Section S _____ T _____ R _____
 3. Miscellaneous S _____ T _____ R JAN 05 2001
 Property in Sec. S _____ T _____ R _____

SECTION

Received for record the
2nd day of OCTOBER
 A. D. 2000 at 10:55 o'clock
A m., and recorded in
 Liber 8 of CORNERS
 on page 41
Ramona Collins, Deputy
 Register of Deeds

Register of Deeds Stamp & File Number

4. Lot No. _____, Recorded Plat _____
 5. Private Claims _____

I, Sheldon M. Van Drese, in a field survey on March 7, 2000, do hereby certify that under requirements of P.A. 74, Michigan P.A. of 1970, the corner points mentioned in lines 1 and 2 above were in conformance with regulations and rules therefor as required in the current manual of survey instructions of the United States Department of the Interior, Bureau of Land Management or by a decree of a Court of Law and/or that the corner points mentioned in lines 3, 4 and 5 above were in conformance with the rules of the Michigan Board of Land Surveyors or by a Decree of a Court of Law; established, re-established, monumented, re-monumented, recovered, found as expressed below:

NOTE: Not more than 4 corners, all in the same town and range, may be recorded on this certificate.

	A	B	C	D	E	F	G	H	I	J	K	L	M
1													
2	6	5	4	3	2	1							
3													
4	7	8	9	10	11	12							
5													
6	18	17	16	15	14	13							
7													
8	19	20	21	22	23	24							
9													
10	30	29	28	27	26	25							
11													
12	31	32	33	34	35	36							
13													

A. Description of original monument and accessories and/or subsequent restoration:
 Corner established by Austin Burt, U.S. Deputy Surveyor, of May 1851. Original bearing trees:
 Sugar 18" S37°W 27 links (17.82 feet)
 Hemlock 20" N75°E 17 links (11.22 feet)
 All original evidence for this corner has been LOST due to decomposition.


B. Description of corner evidence found and/or method applied in restoring or reestablishing corner:
 No original monument or evidence was found, a review of the original GLO notes shows that the West quarter was set at 40.13 chains (midway) between the section corner posts. The GLO notes appear to have two chainage calls in error starting at the Black River, but did not factor into the corner location. A search was made for the stump remains of the original bearing trees but we did not turn up anything with that search. We obtained a railroad r/w map from John Garske that showed a station and offset to the West ¼ corner, the railroad map appears to have a offset distance to the W ¼ that is rounded or estimated. We re-established the West quarter (W ¼) corner using single proportionate measurement using GPS observations. The measured distance between the Northwest corner and the Southwest corner of Section 35 is 5268.34 feet (GLO 5297.16) feet between the two existing section corner monuments. The West line of Section 35 as proportioned was determined to be 4.8 feet East of the documented Section line in the railroad R/W map, I feel that the corner position as monumented is the best solution for the evidence that exists.

Corner research on file with
 Gogebic County records
 R.R.D. 6/21/00

DEED GROUP APPROVED
Richard P. Deahn 6/21/00
 COUNTY REGISTRAR

C. Description of monument for corner and accessories established to perpetuate locating the position of the corner:
 I-12 Set 3 1/4" Dia. X 36" Berntsen aluminum monument stamped with the corner identification and established the following witnesses:

P.K. Nail with shiner in Northeast face fo 10" Sugar Maple	S 30 E 27.16 feet
P.K. Nail with shiner in South face of 14" Sugar Maple	S 64 W 55.86 feet
P.K. Nail with shiner in South face of 10" Sugar Maple	N 86 E 17.81 feet
P.K. Nail with shiner in South face of 12" Sugar Maple	N 58 W 26.74 feet
Sign Post	North 3.00 feet

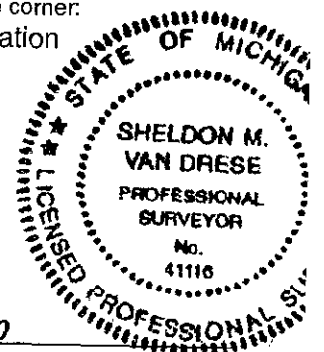

Signed by Sheldon M. Van Drese
 Surveyor's Michigan License No. 41116

Date 05-19-2000