

MAR 02 2000

SECTION

LAND CORNER RECORDATION CERTIFICATE  
Filing Requirement of Act 74, Mich. P.A. 1970

Register's Office }  
Gogebic County } ss.

For corners in

Gogebic  
(County)

Located In:

Corner Code #

1. Public Land Survey

T 48 N 46 W J-9  
T R \_\_\_\_\_  
T R \_\_\_\_\_  
T R \_\_\_\_\_  
S T R \_\_\_\_\_  
S T R \_\_\_\_\_  
S T R \_\_\_\_\_  
S T R \_\_\_\_\_

2. Property Controlling in Section

3. Miscellaneous Property in Sec.

Received for record the  
21<sup>st</sup> day of JULY  
A. D. 1999 at 1:25 o'clock  
P m, and recorded in  
Liber 7 of CORNER  
on page 209  
Ramona Collins, Deputy  
Register of Deeds

Register of Deeds Stamp & File Number

4. Lot No. \_\_\_\_\_, Recorded Plat \_\_\_\_\_

5. Private Claims \_\_\_\_\_

Quarter Corner, Sections 23 & 26, T48N, R46W

I, John P. Goss, in a field survey on June 28, 19 99 do hereby state that under requirements of P.A. 74, Michigan P.A. of 1970, the corner points mentioned in lines 1 and 2 above were in conformance with regulations and rules therefore as required in the current manual of survey instructions of the United States Department of the Interior, Bureau of Land Management or by a decree of a Court of Law and /or that the corner points mentioned in lines 3, 4 and 5 above were in conformance with the rules of the Michigan Board of Land Surveyors or by a Decree of a Court of Law; established, re-established, monumented, recovered, found as expressed below:

NOTE: Not more than 2 corners, all in the same town and range, may be recorded on this certificate.

	A	B	C	D	E	F	G	H	I	J	K	L	M
1													
2	6		5		4		3		2		1		
3													
4	7		8		9		10		11		12		
5													
6	18		17		16		15		14		13		
7													
8	19		20		21		22		23		24		
9													
10	30		29		28		27		26		25		
11													
12	31		32		33		34		35		36		
13													

A. Description of original monument and accessories and/or subsequent restoration:

Corner established by Austin Burt, on May 29, 1851.  
Original bearing trees: Hemlock 28" S 83° W 9 links (5.94 ft.)  
Lynn 14" N 53° E 12 links (7.92 ft.)  
On July 11, 1984, Richard L. Drahn, RLS, restored corner position at record bearing and distance from the remains of the two original bearing trees. He set a 2" aluminum monument with 3 1/4" aluminum cap, stamped to indicated the corner position. He established the following reference objects:  
8" S. Maple N 32° W 14.76'; 13" S. Maple S 68° E 10.02';  
17" S. Maple S 41° W 24.15'; 6' steel sign post N 55° E 1.9'.

B. Description of corner evidence found and/or method applied in restoring or reestablishing corner:  
He recorded said corner in Liber 2, page 683 of Land Corners.

No original evidence found.

Found Richard L. Drahn monument and accessories.

Act 74 research on file.

DEED GROUP APPROVED

Richard L. Drahn 7/20/99

COUNTY REGISTER


C. Description of monument for corner and accessories established to perpetuate locating the position of the corner:

From found monument I established the following new and existing reference objects:

10" Sugar Maple N 32° W 14.76 ft.  
16" Sugar Maple S 68° E 9.87 ft. new nail  
19" Sugar Maple S 41° W 24.16 ft. new nail  
6" Sugar Maple N 19° E 17.10 ft.

(All measurement to nail in side of tree)

6' steel sign post N 55° E 1.9 ft. to face

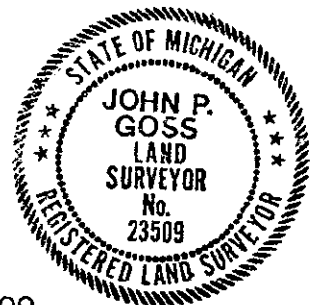

Signed by John P. Goss  
Surveyor's Michigan License No. 23509

Date June 28, 1999

U.S.F.S. NO. R-19