MAR 02 2000

SECTION

LAND CORNER RECORDATION CERTIFICATE
Filing Requirement of Act 74, Mich. P.A. 1970

Register's Office } ss.
Gogebic County }

Received for record the 12TH day of MAY A. D. 1999 at 10:20 o'clock A m., and recorded in Liber 7 of CORNERS on page 151.
Pamela Collins, Deputy
Register of Deeds

Register of Deeds Stamp & File Number

For corners in

Gogebic (County) Located In: Corner Code #

1. Public Land Survey		T48N	R 46W	K-11
		T___	R___	
		T___	R___	
		T___	R___	
2. Property Controlling in Section	S___	T___	R___	
	S___	T___	R___	
3. Miscellaneous Property in Sec.	S___	T___	R___	
	S___	T___	R___	

4. Lot No. _____, Recorded Plat _____
5. Private Claims _____

Section corner, Sections 25,26,35 & 36, T48N,R46W

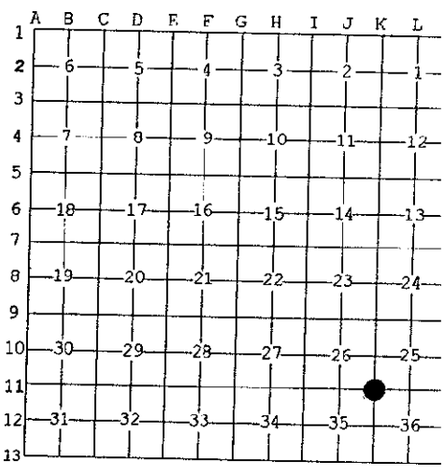

I, John P. Goss, in a field survey on April 23, 19 99 do hereby state that under requirements of P.A. 74, Michigan P.A. of 1970, the corner points mentioned in lines 1 and 2 above were in conformance with regulations and rules therefore as required in the current manual of survey instructions of the United States Department of the Interior, Bureau of Land Management or by a decree of a Court of Law and /or that the corner points mentioned in lines 3, 4 and 5 above were in conformance with the rules of the Michigan Board of Land Surveyors or by a Decree of a Court of Law; established, re-established, monumented, recovered, found as expressed below:

NOTE: Not more than 2 corners, all in the same town and range, may be recorded on this certificate.

A. Description of original monument and accessories and/or subsequent restoration:
Corner established by Austin Burt, U.S. Deputy Surveyor, on May 24, 1851.
Original bearing trees: Sugar 8" S 69° W 30 links (19.80')
Sugar 6" N 65° E 20 links (13.20')
On August 14, 1984, Richard L. Drahn, RLS, USFS, restored corner position at record bearing and distance from remains of Northeast bearing tree and other GLO field calls. He set a 2" aluminum monument with 3¼" cap, stameped to indicate corner position. He established the following reference objects.
7" S. Maple - N 88° W - 8.57'; 7" S. Maple - N 16° E - 15.49';
12" S. Maple - S 66° E - 23.54'; 6' steel sign post - N 43° W - 2.0'

B. Description of corner evidence found and/or method applied in restoring or reestablishing corner:
A 4" squared Cedar post bearing S 25° E - 5.6' from original corner location.
He recorded said corner in Liber 2, page 697 of Land corners for Gogebic County.

Found Richard L. Drahn monument and reference objects.

I Updated the monument and accessories as noted below to state and county specification.

Act 74 research on file.

PEER GROUP APPROVED
Richard L. Drahn 5/11/99
COUNTY REPRESENTATIVE

C. Description of monument for corner and accessories established to perpetuate locating the position of the corner:
From the found monument I established the following existing and new reference objects.

9" Sugar Maple	N 88° W	8.57	ft.
9" Sugar Maple	N 16° E	15.49	ft.
14" Sugar Maple	S 66° E	23.53	ft.
6" Sugar Maple	S 48° W	40.56	ft.
6' Steel sign post	N 43° W	2.0	ft. to face
4" Squared Cedar post	S 25° E	5.6	ft. to face

(All measurement to nail in side of tree)

STATE OF MICHIGAN
JOHN P. GOSS
LAND SURVEYOR
No. 23509
REGISTERED LAND SURVEYOR

Signed by John P Goss Date April 24, 1999
Surveyor's Michigan License No. 23509
U.S.F.S. No. V-21

FORM APPROVED BY MICHIGAN STATE BOARD OF PROFESSIONAL SURVEYORS, JAN. 28, 1971
REVISED MAY 14, 1975
REVISED JAN., 1983
REVISED OCT., 1995