

MAR 02 2000

SECTION

LAND CORNER RECORDATION CERTIFICATE
Filing Requirement of Act 74, Mich. P.A. 1970

Register's Office }
Gogebic County } SA.

Received for record the
12TH day of MAY
A. D. 1999 at 10:20 o'clock
A. m., and recorded in
Liber 7 of CORNER
on page 152
Ramona Collins DeWitt
Register of Deeds

For corners in

<u>Gogebic</u> (County)	Located In:	Corner Code #
1. Public Land Survey	T48 ^N R 46 ^W	K- 12
	T ___ R ___	___
	T ___ R ___	___
2. Property Controlling in Section	S ___ T ___ R ___	___
	S ___ T ___ R ___	___
3. Miscellaneous Property in Sec.	S ___ T ___ R ___	___
	S ___ T ___ R ___	___

Register of Deeds Stamp & File Number

4. Lot No. _____, Recorded Plat _____
5. Private Claims _____

Quaret Corner 35 & 36, T48N, R46W

I, John P. Goss, in a field survey on April 23 19 99 do hereby state that under requirements of P.A. 74, Michigan P.A. of 1970, the corner points mentioned in lines 1 and 2 above were in conformance with regulations and rules therefore as required in the current manual of survey instructions of the United States Department of the Interior, Bureau of Land Management or by a decree of a Court of Law and/or that the corner points mentioned in lines 3, 4 and 5 above were in conformance with the rules of the Michigan Board of Land Surveyors or by a Decree of a Court of Law; established, re-established, monumented, recovered, found as expressed below:

NOTE: Not more than 2 corners, all in the same town and range, may be recorded on this certificate.

A	B	C	D	E	F	G	H	I	J	K	L
1											
2	6		5		4		3		2		1
3											
4	7		8		9		10		11		12
5											
6	18		17		16		15		14		13
7											
8	19		20		21		22		23		24
9											
10	30		29		28		27		26		25
11											
12	31		32		33		34		35		36
13											

A. Description of original monument and accessories and/or subsequent restoration:

Original corner established by Austin Burt, U.S. Deputy Surveyor, on May 25, 18
Original bearing trees: Sugar 22" S 50° W 21 links (13.86')
Sugar 24" N 70° E 27 links (17.82')

On August 14, 1984, Richard L. Drahn, RLS. USFS, restored corner position at record bear and distance from the remains of the Northeast bearing tree and other GLO field calls. He set a 2" iron pipe with 3/4" cap stamped to indicate corner position. He established the following reference objects:
6" Red Maple - N 35° W - 29.80'; 5" S. Maple - N 75° E - 17.82'
6" S. Maple - S 10° E - 40.36'; 6' metal sign post - N 70° E - 1.9'

B. Description of corner evidence found and/or method applied in restoring or reestablishing corner:

3" squared by 4' long Cedar picket bearing N 80° W - 8.4' from original corner
He recorded said corner in Liber 2, page 699 of Land Corners for Gogebic County.

Found Richard L. Drahn monument and reference objects.

I updated the monument and accessories as noted below to state and county specification.


Act 74 research on file.

PEER GROUP APPROVED
Richard L. Drahn 5/11/99
COUNTY REGISTER

C. Description of monument for corner and accessories established to perpetuate locating the position of the corner:
From found monument I established the following existing and new reference objects.

8" Sugar Maple	N 35° W	29.80 ft.	new nail
7" Sugar Maple	N 75° E	17.86 ft.	
9" Sugar Maple	S 10° E	40.25 ft.	new nail
7" Sugar Maple	S 88° W	13.75 ft.	
6' metal sign post	N 70° E	1.9 ft.	to face

(All measurement to nail in side of tree)

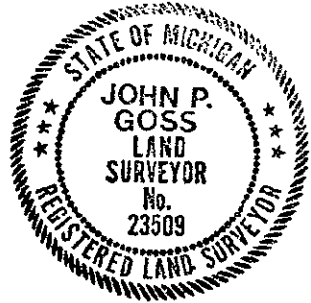

Signed by John P. Goss
Surveyor's Michigan License No. 23509

Date April 24, 1999

U.S.F.S. No. X- 21