

LAND CORNER RECORDATION CERTIFICATE
Filing Requirement of Act 74, Mich. P.A. 1970

Register's Office }
 Gogebic County } ss.

For corners in
Gogebic
 (County)

Located In: _____ Corner Code # _____

Received for record the
8th day of Sept
 A. D. 1993 at 9 o'clock
A m., and recorded in
 Liber 4 of Corners
 page 246-270
Betty Ann Deputy
 Register of Deeds

- | | | |
|------------------------------------|---------------------------|-------------|
| 1. Public Land Survey | T <u>47N</u> R <u>46W</u> | <u>L-1</u> |
| <u>SEC. 1</u> | T _____ R _____ | _____ |
| | T _____ R _____ | _____ |
| | <u>48N</u> R <u>46W</u> | <u>L-13</u> |
| 2. Property Controlling in Section | S _____ T _____ R _____ | _____ |
| 3. Miscellaneous Property in Sec. | S _____ T _____ R _____ | _____ |

Register of Deeds Stamp & File Number

4. Lot No. _____, Recorded Plat _____
 5. Private Claims _____

One quarter corner Sections 36 & 1, T48-47N, R46W

I, _____, in a field survey on August, 1993, do hereby certify that under requirements of P.A. 74, Michigan P.A. of 1970, the corner points mentioned in lines 1 and 2 above were in conformance with regulations and rules therefore as required in the current manual of survey instructions of the United States Department of the Interior, Bureau of Land Management or by a decree of a Court of Law and/or that the corner points mentioned in lines 3, 4 and 5 above were in conformance with the rules of the Michigan Board of Land Surveyors or by a Decree of a Court of Law; established, re-established, monumented, re-monumented, recovered, found as expressed below:

A	B	C	D	E	F	G	H	I	J	K	L	M
2	6	5	4	3	2	1						
3												
4	7	8	9	10	11	12						
5												
6	18	17	16	15	14	13						
7												
8	19	20	21	22	23	24						
9												
10	30	29	28	27	26	25						
11												
12	31	32	33	34	35	36						
13												

NOTE: Not more than 4 corners, all in the same town and range, may be recorded on this certificate.

A. Description of original monument and accessories and/or subsequent restoration:

Original Town Survey by William A. Burt, D.S., in 1848; original Township subdivision by Austin Burt, D.S. in 1851.

Cedar post set at one quarter corner from which:

- A Hemlock 14 in. diameter bears N53E - 33 links
- A Cedar 10 in. diameter bears N50W - 48 links

B. Description of corner evidence found and/or method applied in restoring or reestablishing corner:

No original evidence of the corner position could be found. I re-established the corner by single proportional measurement between the northeast and northwest corners of Section 1.


PEER GROUP APPROVED

Richard R. Decker 4/7/94
 COUNTY REPRESENTATIVE

C. Description of monument for corner and accessories established to perpetuate locating the position of the corner:

I set a 3/4 inch iron rod 2 feet long with a 2 1/2" diameter aluminum cap stamped: T48-47N, R47W, one-quarter cor., S-1 and S-36, 1993, RLS 28410, from which I established the following bearing trees:

- 10" Y. Birch - N78°W - 35.17 feet
- 2" Sugar - N46°E - 2.00 feet
- 6" Red Maple - S66°E - 15.78 feet
- 8" Sugar - S16°W - 25.40 feet

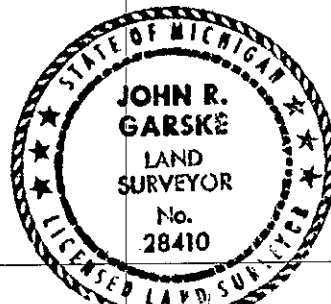

Signed by John R. Garske
 Surveyor's Michigan License No. 28410

Date 9-3-93

246-270