

**LAND CORNER RECORDATION CERTIFICATE**  
**Filing Requirement of Act 74, Mich. P.A. 1970**

Register's office } ss.  
 Gogebic County }

Received for record the  
12<sup>TH</sup> day of April  
 A. D. 1995 at 2:00 o'clock  
P m., and recorded in  
 Liber 5 of Corners  
 on page 247  
Ramona Collins Deutz  
 Register of Deeds

For corners in  
Gogebic  
 (County)

Located in: Corner Code #

- |                                    |   |            |   |            |              |
|------------------------------------|---|------------|---|------------|--------------|
| 1. Public Land Survey              | T | <u>47N</u> | R | <u>46W</u> | <u>M-1</u>   |
|                                    | T | _____      | R | _____      | _____        |
|                                    | T | <u>47N</u> | R | <u>45W</u> | <u>A-#1</u>  |
|                                    | T | _____      | R | _____      | _____        |
| 2. Property Controlling in Section | S | _____      | R | <u>46W</u> | <u>M-13</u>  |
|                                    | S | _____      | T | _____      | _____        |
| 3. Miscellaneous Property in Sec.  | S | _____      | T | <u>48N</u> | <u>R 45W</u> |
|                                    | S | _____      | T | _____      | <u>A-13</u>  |

Register of Deeds Stamp & File Number

4. Lot No. \_\_\_\_\_, Recorded Plat \_\_\_\_\_  
 5. Private Claims \_\_\_\_\_  
 Sec. Cor. Comm. to Sec's. 1,6,31, &36, T47-48N,  
 R45-46W.

A	B	C	D	E	F	G	H	I	J	K	L	M
2	6	5	4	3	2	1						
3												
4	7	8	9	10	11	12						
5												
6	16	17	16	15	14	13						
7												
8	19	20	21	22	23	24						
9												
10	30	29	28	27	26	25						
11												
12	31	32	33	34	35	36						
13												

I, John P. Goss, in a field survey on April 1, 1995, do hereby certify that under requirements of P.A. 74, Michigan P.A. of 1970, the corner points mentioned in lines 1 and 2 above were in conformance with regulations and rules therefore as required in the current manual of survey instructions of the United States Department of the Interior, Bureau of Land Management or by a decree of a Court of Law and/or that the corner points mentioned in lines 3, 4 and 5 above were in conformance with the rules of the Michigan Board of Land Surveyors or by a Decree of a Court of Law; established, re-established, monumented, re-monumented, recovered, found as expressed below:

**NOTE: Not more than 4 corners, all in the same town and range, may be recorded on this certificate.**

A. Description of original monument and accessories and/or subsequent restoration:

Original town lines by John Burt, D.S. in 1847. Set Post.  
 Original Bearing Trees  
     Fir 14"- S 27°E - 13 links.  
     Hemlock 16"- N 19°W- 45 links.

Morris R. Price in 1980 Set a 5/8 inch iron rebar and recorded this corner in Liber 2 on page 61 of Gogebic County Land Corners: 12" Maple- N 40° E 12.50'; 14" Linden- S 29° E- 17.47'; 24" Maple- S 52° W- 30.60'; 2" iron pipe S 56°-49' W- 17.01'

B. Description of corner evidence found and/or method applied in restoring or reestablishing corner:

I found the 5/8 inch rebar marking the corner position and it checked with witnesses in Morris Price certificate. I updated the corner monument and accessories as noted below to state and county specification.


Act 74 reseach on file with the County Register of Deeds Office.

**PEER GROUP APPROVED**  
Richard P. Drab 4/6/95  
 COUNTY REPRESENTATIVE

C. Description of monument for corner and accessories established to perpetuate locating the position of the corner:

I replaced the 5/8 inch rebar with a 2½" x 30" aluminum pipe with a 3¼" aluminum cap stamped: County Remonumentation; S-1, S-6, S-31, S-36; T.47-48 N., R-45-46 W; 1995; P.S. 23509. I established the following bearing trees and reference objects.

- |                 |            |        |
|-----------------|------------|--------|
| 14" Maple       | N 40° E    | 12.50' |
| 15" Basswood    | S 29° E    | 17.53' |
| 11" Maple       | N 20° W    | 37.27' |
| 25" Maple       | S 52° W    | 30.60' |
| Steel Sign Post | Due North  | 0.91'  |
| 2" iron pipe    | S 56°-49'W | 17.01' |

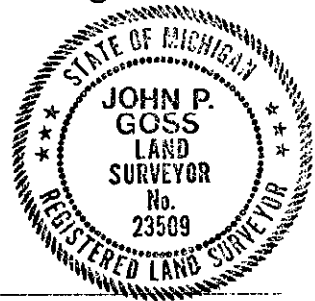

Signed by John P. Goss

Date April 1, 1995

Surveyor's Michigan License No. P.S. 23509