

**LAND CORNER RECORDATION CERTIFICATE**  
**Filing Requirement of Act 74, Mich. P.A. 1970**

For corners in Gogebic Located in: Corner Code #  
 (County)

1. Public Land Survey T48NR48-47W M-3  
T48NR 47W A-3  
 T R  
 T R  
 T R  
 2. Property Controlling S T R  
 in Section S T R  
 3. Miscellaneous S T R  
 Property in Sec. S T R

**SURVEY &  
 REMONUMENTATION**

**JAN 05 2001**

4. Lot No. \_\_\_\_\_, Recorded Plat \_\_\_\_\_  
 5. Private Claims \_\_\_\_\_  
 Section Corner common to Sections 1, 6, 7, and 12. **SECTION**

Register's Office }  
 Gogebic County } ss.

Received for record the  
2<sup>ND</sup> day of JUNE  
 A. D. 19<sup>TH</sup> 00 at 10:20 o'clock  
A m., and recorded in  
 Liber 7 of CORNERS

on page 367  
*Cheryl Rupp, Dep.*  
 Register of Deeds

Register of Deeds Stamp & File  
 Number

I, John R. Garske, in a field survey on April 24, 2000, do hereby state that under requirements of P.A. 74, Michigan P.A. of 1970, the corner points mentioned in lines 1 and 2 above were in conformance with regulations and rules therefore as required in the current manual of survey instructions of the United States Department of the Interior, Bureau of Land Management or by a decree of a Court of Law and / or that the corner points mentioned in lines 3, 4, and 5 above were in conformance with the rules of the Michigan Board of Land Surveyors or by a Decree of a Court of Law; established, re-established, monumented, recovered, found as expressed below.

NOTE: Not more than 2 corners, all in the same town and range, may be recorded on this certificate.

	A	B	C	D	E	F	G	H	I	J	K	L	M
1													
2	6		5		4		3		2		1		
3													
4	7		8		9		10		11		12		
5													
6	18		17		16		15		14		13		
7													
8	19		20		21		22		23		24		
9													
10	30		29		28		27		26		25		
11													
12	31		32		33		34		35		36		
13													

**A. Description of original monument and accessories and / or subsequent restoration:**

Original survey by William Ives in 1848. \*\*\*\*\*  
 Original Corner: Cedar post  
 Original Bearing Trees: 12" Spruce S 58° W 133 Links  
 8" Spruce N 12° W 94 Links

**B. Description of corner evidence found and / or method applied in restoring or re-establishing corner:**

I set a survey spike as monumenting the Southeast corner position of Section 1, T 48 N, R 48 W on the range line in the center of Lake Road. This position checks well with the 1936 survey by the Gogebic County Forestry Commission. The 1936 survey shows the corner in the centerline of Lake Road on the extension of the road centerline from the north.

Record Research on File  
 (See Sketch on back)

DEED GROUP APPROVED  
*Richard R. Decker 5/24/00*  
 COUNTY REGISTER


**C. Description of monument for corner and accessories established to perpetuate locating the position of the corner:**

I set a 5/8" x 30" rebar with brass cap, from which I established the following witnesses:  
 Reference Monument with S.S.P. North 47.00 feet  
 Power Pole (set D.H. nail in N. Side) N 75° E 107.40 feet  
 7" Balsam S 02° W 57.90 feet  
 20" Cedar S 63° W 88.03 feet

Signed by John R. Garske

Date 5/24/00

Surveyor's Michigan License No. 28410  
 FB # 239, page 12/1

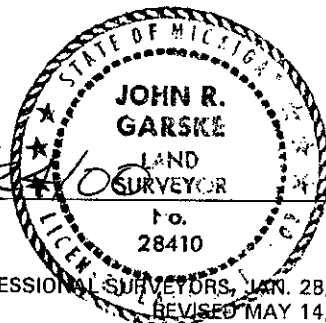

Section Corner common to Sections 1, 6, 7, & 12,  
T 48 N, R 47-48 W.



Not to scale

SURVEY &  
REMONUMENTATION

JAN 05 2001

SECTION

