

MAR 02 2000

SECTION

LAND CORNER RECORDATION CERTIFICATE  
Filing Requirement of Act 74, Mich. P.A. 1970

Register's Office }  
Gogebic County } ss.

For corners in

Gogebic  
(County)

Located In:

Corner Code #

1. Public Land Survey

T48<sup>N</sup>R47<sup>W</sup>      0-3

T      R

T      R

T      R

2. Property Controlling  
in Section

S      T      R

S      T      R

3. Miscellaneous  
Property in Sec.

S      T      R

S      T      R

Received for record the  
22<sup>ND</sup> day of SEPTEMBER  
A. D. 1999 at 1:00 o'clock  
P m., and recorded in  
Liber 7 of CORNERS  
on page 253  
Ramona Collins, Deputy  
Register of Deeds

Register of Deeds Stamp & File Number


4. Lot No. \_\_\_\_\_, Recorded Plat \_\_\_\_\_

5. Private Claims \_\_\_\_\_

Section Corner, 5,6,7 & 8, T48N,R47W

I, John P. Goss, in a field survey on Aug. 30, 1999 do hereby state that under requirements of P.A. 74, Michigan P.A. of 1970, the corner points mentioned in lines 1 and 2 above were in conformance with regulations and rules therefore as required in the current manual of survey instructions of the United States Department of the Interior, Bureau of Land Management or by a decree of a Court of Law and/or that the corner points mentioned in lines 3, 4 and 5 above were in conformance with the rules of the Michigan Board of Land Surveyors or by a Decree of a Court of Law; established, re-established, monumented, recovered, found as expressed below:

NOTE: Not more than 2 corners, all in the same town and range, may be recorded on this certificate.

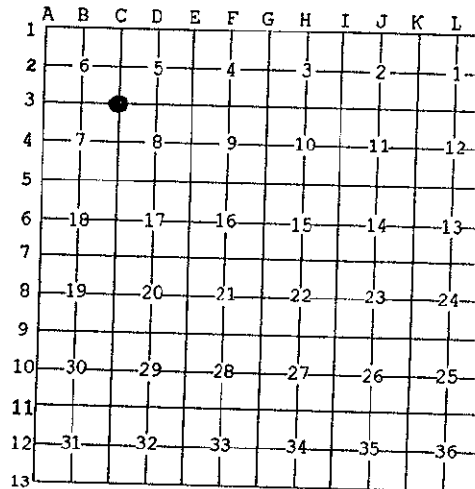

A. Description of original monument and accessories and/or subsequent restoration:

Corner established by William Ives, on Sept. 23, 1858. Set post.  
Original bearing trees: Sugar 10" S 16° W 23 links (15.18 ft.)  
Sugar 10" N 36° W 34 links (22.44 ft.)

B. Description of corner evidence found and/or method applied in restoring or reestablishing corner:

No original evidence found due to road construction.  
Found a P.K. nail in intersection of a East-West paved road and a North-South gravel road.  
I accept the P.K. nail as the best evidence for restoring the corner position.

Act 74 research on file.

DEED GROUP APPROVED  
Richard L. Drain 9/21/99  
COUNTY REGISTER

C. Description of monument for corner and accessories established to perpetuate locating the position of the corner:

I replaced the P.K. nail with a 3/4" brass cap stamped: County Remonumentation; T.48 N., R.47 W.; S-5, S-6, S-7, S-8; 1999; P.S. 23509 over a 1/2" by 10" rebar; from which I established the following reference objects:

15" Hemlock      N 31° E      85.01 ft.  
6" Poplar      S 26° W      77.25 ft.  
P.Pole #6-93/05      N 48° W      50.79 ft.  
Reference Monument consisting of a 2 1/2" x 30" aluminum monument with a 3/4" aluminum cap stamped to indicated corner position:  
N 48° W -48.10 ft., with 6' rail 0.98 ft.



Signed by John P. Goss  
Surveyor's Michigan License No. 23509

Date August 31, 1999

U.S.F.S. No. E-5