

**LAND CORNER RECORDATION CERTIFICATE**  
**Filing Requirement of Act 74, Mich. P.A. 1970**

Register's office }  
 Segebic County } 88.

For corners in

Gogebic Located In: Corner Code #  
 (County)

1. Public Land Survey T48N R 47W C - 4  
 T R  
 T R  
 T R

2. Property Controlling S T R  
 in Section S T R

3. Miscellaneous S T R  
 Property in Sec. S T R

**SURVEY &  
 MONUMENTATION**  
**JAN 05 2001**

Received for record the  
2<sup>ND</sup> day of JUNE  
 A. D. 2000 at 10:30 o'clock  
A m., and recorded in  
 Liber 7 of CORNERS  
 on page 370

Cheyl Ruppel  
 Register of Deeds  
 Register of Deeds Stamp & File Number

4. Lot No. \_\_\_\_\_, Recorded Plat \_\_\_\_\_  
 5. Private Claims \_\_\_\_\_  
 Quarter Corner common to Sections 7 & 8, T 48 N, R 47 W

A	B	C	D	E	F	G	H	I	J	K	L
1											
2	6		5		4		3		2		1
3											
4	7	●	8		9		10		11		12
5											
6	18		17		16		15		14		13
7											
8	19		20		21		22		23		24
9											
10	30		29		28		27		26		25
11											
12	31		32		33		34		35		36
13											

I, John R. Garske, in a field survey on December 15, 1999 do hereby state that under requirements of P.A. 74, Michigan P.A. of 1970, the corner points mentioned in lines 1 and 2 above were in conformance with regulations and rules therefore as required in the current manual of survey instructions of the United States Department of the Interior, Bureau of Land Management or by a decree of a Court of Law and /or that the corner points mentioned in lines 3, 4 and 5 above were in conformance with the rules of the Michigan Board of Land Surveyors or by a Decree of a Court of Law; established, re-established, monumented, recovered, found as expressed below:

**NOTE: Not more than 2 corners, all in the same town and range, may be recorded on this certificate.**

**A. Description of original monument and accessories and/or subsequent restoration:**

Original Survey: William Ives, P.S., in 1848  
 Original Corner: Wood Post  
 Original Bearing Trees: 12" Fir S 35° W 33 Links  
 15" Elm N 12° E 15 Links

**B. Description of corner evidence found and/or method applied in restoring or reestablishing corner:**

No corner evidence found. Set point in the centerline of Mud Creek Road opposite of iron pipe on West side of road. Blue lines run East and West from this point. The GLO distance North to the creek checks quite well with this location as does the distance North 2653.22 feet to the corner in Lake Road.


Record Research on file.

Richard L. Drahn 5/24/00  
 COUNTY BENHART

**C. Description of monument for corner and accessories established to perpetuate locating the position of the corner:**

I set a 5/8" iron rod with a stamped brass cap in the centerline of Mud Creek Road and a standard 2 1/2" x 42" aluminum Bernsten monument as a reference monument. Also, established the following witnesses:

Reference monument	S 56° W	33.75 Feet
8" Basswood	N 54° W	46.94 Feet
12" Basswood	N 68° E	31.47 Feet
7" Cherry	S 46° E	42.19 Feet

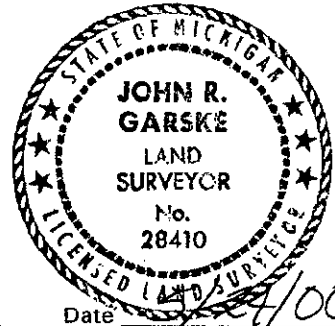

Signed by John R. Garske  
 Surveyor's Michigan License No. 28410  
 Field Book # 239, Page 103

Date 5/24/00