

SURVEY & REMONUMENTATION

JAN 22 1998

SECTION

LAND CORNER RECORDATION CERTIFICATE
Filing Requirement of Act 74, Mich. P.A. 1970

Register's Office }
Gogebic County } ss.

Received for record the
22ND day of DECEMBER
A. D. 1997 at 11:00 o'clock
A m., and recorded in
Liber 6 of CORNERS
on page 302
Ramona Collins, Deputy
Register of Deeds

Register of Deeds Stamp & File Number

For corners in
Gogebic

(County)

Located In:	Corner Code #
Section 29 48N 47W	D-11
T R	
T R	
T R	
T R	
S T R	
S T R	
S T R	
S T R	

1. Public Land Survey

2. Property Controlling in Section

3. Miscellaneous Property in Sec.

4. Lot No. _____, Recorded Plat _____
5. Private Claims _____

1/4 corner sections 29 & 32, T48N, R47W

I, John R. Garske, in a field survey on December 10, 1997 do hereby state that under requirements of P.A. 74, Michigan P.A. of 1970, the corner points mentioned in lines 1 and 2 above were in conformance with regulations and rules therefore as required in the current manual of survey instructions of the United States Department of the Interior, Bureau of Land Management or by a decree of a Court of Law and for that the corner points mentioned in lines 3, 4 and 5 above were in conformance with the rules of the Michigan Board of Land Surveyors or by a Decree of a Court of Law; established, re-established, monumented, recovered, found as expressed below:

NOTE: Not more than 2 corners, all in the same town and range, may be recorded on this certificate.

	A	B	C	D	E	F	G	H	I	J	K	L	M
1													
2	6		5		4		3		2				
3													
4	7		8		9		10		11		12		
5													
6	18		17		16		15		14		13		
7													
8	19		20		21		22		23		24		
9													
10	30		29		28		27		26		25		
11													
12	31		32		33		34		35		36		
13													


A. Description of original monument and accessories and/or subsequent restoration:

Original Township survey by William A. Burt in 1848.
He set a wood post from which:
Spruce 4" N22°E 18 links
Tamarack 5" S44°W 35 links

B. Description of corner evidence found and/or method applied in restoring or reestablishing corner: Richard R. W. [Signature] 12/19/97
GOGEBIC REMONUMENTATION


No evidence of the original corner exists. I established the corner at the centerline intersection of Saari Lane and Airport Road. Distances to existing fences at "40" lines checks well with this location and is the most logical position for the 1/4 corner.

(Research on file)

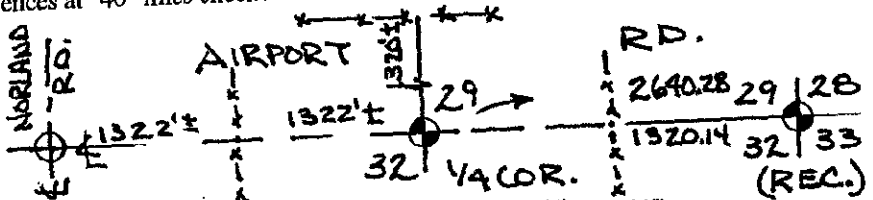

C. Description of monument for corner and accessories established to perpetuate locating the position of the corner:

I set a 5/8" x 10" iron rod with a 3 1/4" dia. brass cap, stamped to identify the corner from which:
Power Pole N40°E 33.88 feet
Power Pole S50°E 29.78 feet
7" Maple S40°E 51.73 feet
Reference monument (R.M.) N48°W - 42.88 feet - steel sign rail - 1.27 feet
(R.M. - 2 1/2" dia. x 30" long alum. pipe with a 3 1/4" dia. alum. cap)

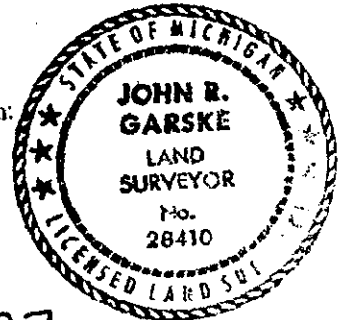

Signed by John R. Garske
Surveyor's Michigan License No. 28410

Date 12/19/97