

SURVEY & REMONUMENTATION

OCT 03 1996

COMMISSION

LAND CORNER RECORDATION CERTIFICATE

Filing Requirement of Act 74, Mich. P.A. 1970

For corners in Gogebic
(County)

Located in:

Corner Code #

1. Public Land Survey	T	48N	R	47W	F-3
	T		R		
	T		R		
	T		R		
2. Property Controlling in Section	S		T	R	
	S		T	R	
3. Miscellaneous Property in Section	S		T	R	
	S		T	R	

Register's Office }
Gogebic County } ss.

Received for record the
16TH day of AUGUST
A. D. 1996 at 11:15 o'clock
A m., and recorded in
Liber 6 of CORNERS
on page 29
Namona Collins, Deputy
Register of Deeds

Register of Deeds Stamp & File Number

4. Lot No. _____, Recorded Plat _____
5. Private Claims _____

1/4 Corner Sections 4&9, T48N, R47W.

John R. Garske _____ May 8 _____ 96

I, _____, in a field survey on _____, 19 _____, do hereby certify that under requirements of P.A. 74, Michigan P.A. of 1970, the corner points mentioned in lines 1 and 2 above were in conformance with regulations and rules therefore as required in the current manual of survey instructions of the United States Department of the Interior, Bureau of Land Management or by a decree of a Court of Law and/or that the corner points mentioned in lines 3, 4 and 5 above were in conformance with the rules of the Michigan Board of Professional Surveyors or by a Decree of a Court of Law; established, re-established, monumented, re-monumented, recovered, found as expressed below:

NOTE: Not more than 4 corners, all in the same town and range, may be recorded on this certificate.

A	B	C	D	E	F	G	H	I	J	K	L	M
2	6	5			4		3		2		1	
3					●							
4	7	8			9		10		11		12	
5												
6	18	17			16		15		14		13	
7												
8	19	20			21		22		23		24	
9												
10	30	29			28		27		26		25	
11												
12	31	32			33		34		35		36	
13												


A. Description of original monument and accessories and/or subsequent restoration:

- Original Township Survey by William A. Burt, D.S., 1847.
- Original Township Subdivision By William Ives, D.S. Sept. 11-24, 1848.
- Original Bearing Trees: Sugar 12"-S65°W-8 links, Sugar 12"-N36°E-28 links.
- In 1991 J. Garske and J. Goss, RLS, set a P.K. nail in centerline of Lake Road and established the following bearing trees:
Pine 4" N11°W-40.30 feet,
Power pole S72°W-93.22 feet,
Hemlock 12"-N66°E-82.40.
Corner recorded in Liber 4 of land corners, pg. 9.

B. Description of corner evidence found and/or method applied in restoring or reestablishing corner:

I found the P.K. nail as noted above with the corner accessories in good condition. I updated the corner to state and county specifications by establishing reference monuments noted below.

P.A. 74 Research on file.

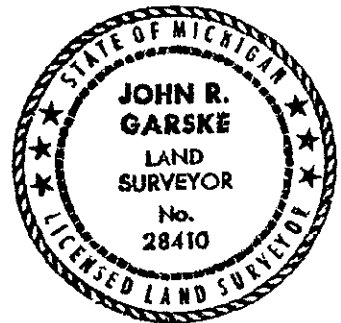

C. Description of monument for corner and accessories established to perpetuate locating the position of the corner:

I established the following reference objects from the P.K. nail:

2 1/2" aluminum pipe with 3 1/4" diameter aluminum cap stamped; T48N, R47W, R.M., 1/4, S.4, S.5, 1995, RLS 28410, N49°E, 39.96', with a steel sign rail-0.65 feet away.

Another reference monument was stamped the same as above except S23°E, 30.48' with a steel sign post 0.75 feet away.

- Pine 4" N11°W-40.30 feet,
- Power pole S72°W-93.22 feet,
- Hemlock 12"-N66°E-82.40.

PEER GROUP APPROVED

Richard R. Dahn 8/14/96
COUNTY REPRESENTATIVE

Signed by John R. Garske

Date 8-4-96

Surveyor's Michigan License No. 28410

FORM APPROVED BY MICHIGAN STATE BOARD OF PROFESSIONAL SURVEYORS, JAN. 28, 1971
REVISED MAY 14, 1975
REVISED JAN., 1983