Register's Office } ss.
Gogebic County }

Received for record the 16TH day of DECEMBER A. D. 1994 at 10:45 o'clock A m., and recorded in Liber 5 of CORNERS on page 172.

Ramona Collins Deputy
Register of Deeds

Register of Deeds Stamp & File Number

LAND CORNER RECORDATION CERTIFICATE

Filing Requirement of Act 74, Mich. P.A. 1970

For corners in Gogebic (County)

	Located In:	Corner Code ##
1. Public Land Survey Section 4	T 47N R 47W	F-1
	T ___ R ___	
	T ___ R ___	
	T 48N R 47W.	F-13
2. Property Controlling	S ___ T ___ R ___	
in Section	S ___ T ___ R ___	
3. Miscellaneous	S ___ T ___ R ___	
Property in Sec.	S ___ T ___ R ___	

4. Lot No. _____, Recorded Plat _____
5. Private Claims _____

One-quarter corner common to Section 4, T47N, R47W and Section 33, T48N, R47W.

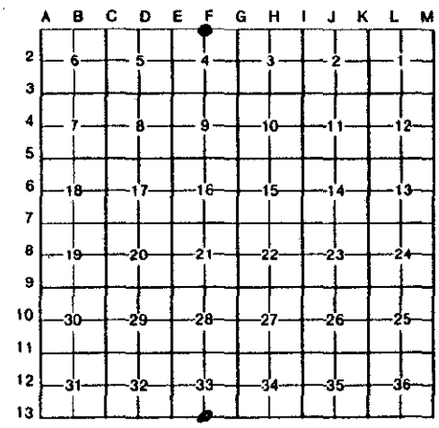

I, John R. Garske, in a field survey on December 7, 19 94, do hereby certify that under requirements of P.A. 74, Michigan P.A. of 1970, the corner points mentioned in lines 1 and 2 above were in conformance with regulations and rules therefore as required in the current manual of survey instructions of the United States Department of the Interior, Bureau of Land Management or by a decree of a Court of Law and/or that the corner points mentioned in lines 3, 4 and 5 above were in conformance with the rules of the Michigan Board of Land Surveyors or by a Decree of a Court of Law; established, re-established, monumented, re-monumented, recovered, found as expressed below:

NOTE: Not more than 4 corners, all in the same town and range, may be recorded on this certificate.

A. Description of original monument and accessories and/or subsequent restoration:

Original survey by William Ives, Deputy Surveyor, in 1848. Original corner was a sugar post and original bearing trees are: hemlock 18" - N37°E, 12 links (7.92'); hemlock 16" - N67°W, 22 links (14.52').

B. Description of corner evidence found and/or method applied in restoring or reestablishing corner:

No original evidence could be found due to road construction. Re-established the corner position by single proportionate measurement. Corner set on line and midway between section corners to the east and west. The corner falls approximately one foot south of the paved road centerline and six feet west of a fence to the north which runs approximately 200 feet northerly and stops at a creek.

Record research form on file with County Register of Deeds office.

PEER GROUP **Approved**

Richard L. Drahn 12/15/94

C. Description of monument for corner and accessories established to perpetuate locating the position of the corner:

Set a 2 1/2" brass cap with a 2" stem 2" below asphalt road surface. Cap is stamped: County Remonumentation; T48N, R47W, 1/4; S-33, S-4; T47N, 1994; RLS 28410. I established the following bearing trees and reference objects: Power Pole #300-N78°E, 176.39 feet; Power Pole #299 - N65°W, 88.83 feet; twin 6" elm - S68°W, 92.53 feet. Reference monument consisting of a 2 1/2" x 30" aluminum pipe with a 3 1/4" aluminum cap stamped to indicate the corner position - due north, 43.68 feet with a 6' steel rail with sign 1.32 feet away.

STATE OF MICHIGAN
JOHN R. GARSKE
LAND SURVEYOR
No. 28410
LICENSED LAND SURVEYOR

Signed by John R Garske Date 12/14/94

Surveyor's Michigan License No. 28410

FORM APPROVED BY MICHIGAN STATE BOARD OF LAND SURVEYORS, JAN. 28, 1971
REVISED MAY 14, 1975
REVISED JAN., 1983