

**SURVEY &  
REMONUMENTATION**

JUN 29 1995

**COMMISSION**

**LAND CORNER RECORDATION CERTIFICATE  
Filing Requirement of Act 74, Mich. P.A. 1970**

For corners in

Register's Office } ss.  
Gogebic County }

<u>Gogebic</u> (County)	Located In:	Corner Code #
1. Public Land Survey	T <u>48N</u> R <u>47W</u>	<u>G-3</u>
	T _____ R _____	_____
	T _____ R _____	_____
	T _____ R _____	_____
2. Property Controlling in Section	S _____ T _____ R _____	_____
	S _____ T _____ R _____	_____
3. Miscellaneous Property in Sec.	S _____ T _____ R _____	_____
	S _____ T _____ R _____	_____

Received for record the  
12<sup>th</sup> day of APRIL  
A. D. 1995 at 1:30 o'clock  
P m., and recorded in  
Lib 5 of CORNERS  
on page 239  
Ramona Collins Deputy  
Register of Deeds  
Register of Deeds Stamp & File Number

4. Lot No. \_\_\_\_\_, Recorded Plat \_\_\_\_\_  
5. Private Claims \_\_\_\_\_  
Section corner common to Sections 3, 4, 9 and 10, T48N, R47W

	A	B	C	D	E	F	G	H	I	J	K	L	M
2	6	5	4	3	2	1							
3							⊙						
4	7	8	9	10	11	12							
5													
6	18	17	16	15	14	13							
7													
8	19	20	21	22	23	24							
9													
10	30	29	28	27	26	25							
11													
12	31	32	33	34	35	36							
13													

I, John R. Garske, in a field survey on March 30, 1995, do hereby certify that under requirements of P.A. 74, Michigan P.A. of 1970, the corner points mentioned in lines 1 and 2 above were in conformance with regulations and rules therefore as required in the current manual of survey instructions of the United States Department of the Interior, Bureau of Land Management or by a decree of a Court of Law and/or that the corner points mentioned in lines 3, 4 and 5 above were in conformance with the rules of the Michigan Board of Land Surveyors or by a Decree of a Court of Law, established, re-established, monumented, re-monumented, recovered, found as expressed below:

**NOTE: Not more than 4 corners, all in the same town and range, may be recorded on this certificate.**


- A. Description of original monument and accessories and/or subsequent restoration:
- On September 18, 1848, William Ives set a post from which a 18" hemlock bears S53°E, 24 links and a 30" hemlock - N63°W, 25 links.
  - 1975-76 survey by Duane Peterson, RLS 14402, shows corner position marked by a hub at the intersection of the extended centerline of Lake Road.
  - July 16, 1990, survey by John R. Garske, RLS 28410 and John P. Goss, RLS 23509. Found a 1/2" iron pipe at corner location, probably set by Champion Timberlands. I accepted the pipe and reset a 2" diameter x 3' long iron pipe with a 2 1/2" diameter brass cap stamped: 3, 4, 9 & 10, T48N, R47W, RLS 28410, 1990. Bearing trees: 5" maple - N01°W, 6.45 feet; 6" maple - S67°E, 7.30 feet; 6" maple - S62°W, 15.37 feet. Recorded September 16, 1991, in L.4, Pg. 7 of Land Corners.

- B. Description of corner evidence found and/or method applied in restoring or reestablishing corner:
- Found brass capped iron pipe and bearing trees as noted in last entry above. The corner and its accessories were found in good condition.

Record research on file with Register of Deeds.

**PEER GROUP APPROVED**  
Richard L. Drain 4/6/95  
**COUNTY REPRESENTATIVE**

- C. Description of monument for corner and accessories established to perpetuate locating the position of the corner:
- I updated the corner position to state and county specifications. The corner position is marked by a 2" diameter x 30" long iron pipe with a 2 1/2" diameter brass cap stamped: 3, 4, 9 & 10, T48N, R47W; RLS 28410, 1990. Bearing trees:
- 6" maple - N01°W, 6.45 feet
  - 7" maple - S67°E, 7.30 feet
  - 7" maple - S62°W, 15.37 feet
  - 6' steel rail with sign - S06°W, 1.68 feet

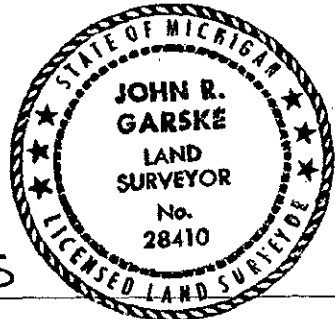

Signed by John R. Garske Date 4-6-95  
Surveyor's Michigan License No. 28410