

LAND CORNER RECORDATION CERTIFICATE
Filing Requirement of Act 74, Mich. P.A. 1970

For corners in Gogebic (County) Located in: _____ Corner Code # _____

1. Public Land Survey T48NR47W G-4
 T _____ R _____
 T _____ R _____
 T _____ R _____

2. Property Controlling S _____ T _____
 in Section S _____ T _____

3. Miscellaneous S _____ T _____
 Property in Sec. S _____ T _____

4. Lot No. _____, Recorded Plat _____

5. Private Claims _____

Quarter Corner common to Sections 9 & 10.

Register's Office }
 Gogebic County }

Received for record the
2ND day of JUNE
 A. D. 1900 at 10:30 o'clock
A m., and recorded in
 Liber 7 of CORNERS
 on page 372
Cheryl Ruppel
 Register of Deeds
 Register of Deeds Stamp & File Number

I, John R. Garske, in a field survey on April 24, 2000, do hereby state that under requirements of P.A. 74, Michigan P.A. of 1970, the corner points mentioned in lines 1 and 2 above were in conformance with regulations and rules therefore as required in the current manual of survey instructions of the United States Department of the Interior, Bureau of Land Management or by a decree of a Court of Law and / or that the corner points mentioned in lines 3, 4, and 5 above were in conformance with the rules of the Michigan Board of Land Surveyors or by a Decree of a Court of Law; established, re-established, monumented, recovered, found as expressed below.

NOTE: Not more than 2 corners, all in the same town and range, may be recorded on this certificate.

	A	B	C	D	E	F	G	H	I	J	K	L	M
1													
2	6			5			4			3			2
3													
4	7			8			9			10			11
5													
6	18			17			16			15			14
7													
8	19			20			21			22			23
9													
10	30			29			28			27			26
11													
12	31			32			33			34			35
13													

A. Description of original monument and accessories and / or subsequent restoration:

Original survey by William Ives in 1848.
 Original Corner: Wood post
 Original Bearing Trees: 12" Yellow Birch S 57° E 24 Links
 8" Birch N 30° W 22 Links

B. Description of corner evidence found and / or method applied in restoring or re-establishing corner:

I set a survey spike in the centerline of Lake Road at the quarter corner position at a proportional distance north and south.

(Record Research on File)

(See Sketch on back)

Richard D. Dean 5/24/00
 COUNTY REGISTER

C. Description of monument for corner and accessories established to perpetuate locating the position of the corner:

I set a 5/8" x 24" rebar with brass cap as monumenting the East corner of Section 9, from which I established the following witnesses:

Power Pole	N 12° W	111.26 Feet
Cedar	N 75° W	62.50 Feet
Cedar	N 57° E	63.83 Feet
Reference Monument	S 62° W	50.00 Feet

(3/4" x 48" long aluminum rod with cap) (with steel sign post, 1.5')


Signed by _____

John R. Garske

Date _____

5/24/00 No. 28410

Surveyor's Michigan License No. 28410
 FB # 239, page 118

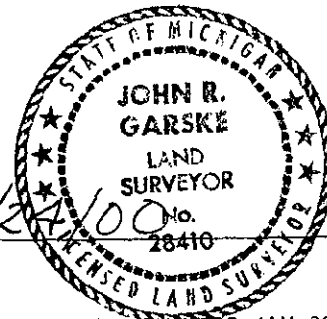

Quarter Corner common to Sections 9 & 10
T 48 N, R 47 W.

6-4



Scale: 1" = 200'

SURVEY &
REMONUMENTATION

JAN 05 2001

SECTION

