

MAR 02 2000

SECTION

LAND CORNER RECORDATION CERTIFICATE
Filing Requirement of Act 74, Mich. P.A. 1970

Register's Office }
Gegebic County } ss.

Received for record the
21st day of JULY
A. D. 1999 at 1:35 o'clock
P m., and recorded in
Liber 7 of CORNERS
on page 214
Ramona Collins Deputy
Register of Deeds

Register of Deeds Stamp & File Number

For corners in


| | | |
|------------------------------------|---------------------------|---------------|
| <u>Gegebic</u> (County) | Located in: | Corner Code # |
| 1. Public Land Survey Section 22 | T <u>48N</u> R <u>47W</u> | <u>G-8</u> |
| | T _____ R _____ | _____ |
| | T _____ R _____ | _____ |
| | T _____ R _____ | _____ |
| 2. Property Controlling in Section | S _____ T _____ R _____ | _____ |
| | S _____ T _____ R _____ | _____ |
| 3. Miscellaneous Property in Sec. | S _____ T _____ R _____ | _____ |
| | S _____ T _____ R _____ | _____ |

4. Lot No. _____, Recorded Plat _____
5. Private Claims _____

Quarter corner to sections 21 & 22, T48N, R47W

I, John R. Garske in a field survey on June 10, 1999 do hereby state that under requirements of P.A. 74, Michigan P.A. of 1970, the corner points mentioned in lines 1 and 2 above were in conformance with regulations and rules therefore as required in the current manual of survey instructions of the United States Department of the Interior, Bureau of Land Management or by a decree of a Court of Law and /or that the corner points mentioned in lines 3, 4 and 5 above were in conformance with the rules of the Michigan Board of Land Surveyors or by a Decree of a Court of Law, established, re-established, monumented, recovered, found as expressed below.

NOTE: Not more than 2 corners, all in the same town and range, may be recorded on this certificate.

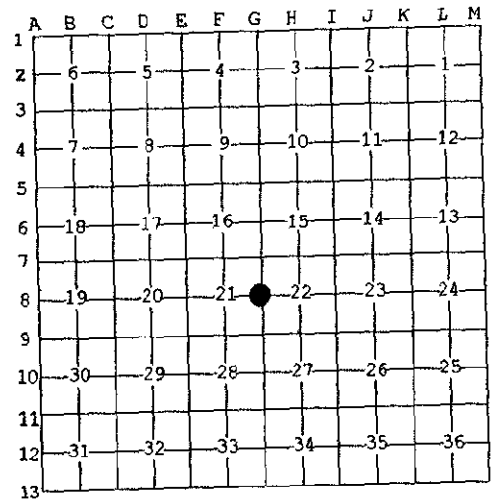

A. Description of original monument and accessories and/or subsequent restoration:

Original Survey by William Ives, D.S. in 1848.
Original bearing trees:
A. fir 8" S55°W 33 links
A. Hemlock 12" N50°E 23 links

B. Description of corner evidence found and/or method applied in restoring or reestablishing corner:

I established the corner position at the centerline intersection of Orchard Lane and Vanderhagen Rd. This position fits well with corners north (2622.11 feet) and south (2640.71 feet).

PEER GROUP APPROVED
Richard K. Drain 7/20/99
COUNTY REPRESENTATIVE

(Research on file)

C. Description of monument for corner and accessories established to perpetuate locating the position of the corner:

I set a 12" x 5/8" iron rod with a 3 1/4" brass cap in the road centerline, from which:
Power pole S62°E 30.41 feet
Power pole S68°W 43.43 feet
12" scotch pine N50°W 43.58 feet
12" aspen N31°E 74.03 feet
aluminum reference monument S48°W 54.85 feet
steel sign nail 1.00 feet from RM@ S48°W

Signed by J. W. R. Garske
Surveyor's Michigan License No. 28410

Date 7/20/99
No. 28410

