

DEC 15 1998

SECTION

LAND CORNER RECORDATION CERTIFICATE
Filing Requirement of Act 74, Mich. P.A. 1970

Register's Office
Gogebic County

Received for record the
30TH day of October
A. D. 1998 at 9:05 o'clock
A. M., and recorded in
Liber 7 of CORNERS
on page 72
Ramonah Collins Dep.
Register of Deeds

For corners in

GOGEBIC
(County)

Located In:

Corner Code #

- 1. Public Land Survey
SECTION 21 T 48 R 47 W G-9
- 2. Property Controlling in Section
S T R
- 3. Miscellaneous Property in Sec.
S T R


Register of Deeds Stamp & File Number

- 4. Lot No. _____, Recorded Plat _____
- 5. Private Claims _____

SECTION CORNER TO 21, 22, 27 & 28, T48N, R47W

I, JOHN R GARSKE, in a field survey on SEPT. 28, 19 98 do hereby state that under requirements of P.A. 74, Michigan P.A. of 1970, the corner points mentioned in lines 1 and 2 above were in conformance with regulations and rules therefore as required in the current manual of survey instructions of the United States Department of the Interior, Bureau of Land Management or by a decree of a Court of Law and /or that the corner points mentioned in lines 3, 4 and 5 above were in conformance with the rules of the Michigan Board of Land Surveyors or by a Decree of a Court of Law; established, re-established, monumented, recovered, found as expressed below:

NOTE: Not more than 2 corners, all in the same town and range, may be recorded on this certificate.

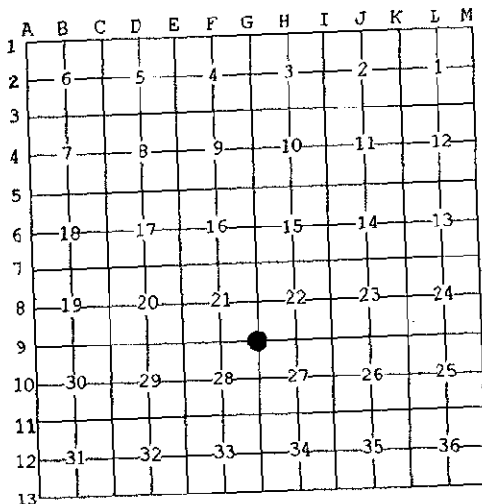

A. Description of original monument and accessories and/or subsequent restoration:

ORIGINAL TOWNSHIP SURVEY BY WILLIAM BURT, D.S. 1847.
ORIGINAL CORNER, SET BY WILLIAM IVES, D.S. IN 1848.
ORIGINAL BEARING TREES:

SUGAR	10"	S68°E	8 LINKS
SUGAR	12"	N44°W	29 LINKS

B. Description of corner evidence found and/or method applied in restoring or reestablishing corner:

I ESTABLISHED THE CORNER AT THE CENTERLINE INTERSECTION OF VANDERHAGEN AND PILOA ROADS. I FOUND NOTHING AT THE POSITION BUT IT IS OBVIOUSLY AN OLD AND WELL ESTABLISHED ROAD INTERSECTION. MEASUREMENTS TO FENCE LINES INTERSECTING THE ROADS IN ALL FOUR DIRECTIONS CHECK WELL WITH THIS POSITION.

PEER GROUP APPROVED
Richard L. Whelan 10/27/98
COUNTY REGISTER

(RESEARCH ON FILE)

C. Description of monument for corner and accessories established to perpetuate locating the position of the corner:

I SET A 3 1/4" STAMPED BRASS CAP ON A 5/8" X 12" IRON ROD AT THE CORNER POSITION FROM WHICH I ESTABLISHED:
REFERENCE MONUMENT - 2 1/2' ALUMINUM PIPE WITH A 3 1/4" STAMPED

ALUMINUM CAP	N54°W	48.40 FEET
SIGN RAIL	N54°W	1.50 FEET FROM R.M
6" SPRUCE	N51°E	65.20 FEET
P.POLE	S48°W	58.10 FEET

Signed by John R Garske
Surveyor's Michigan License No. 28410

Date 10-26-98

