

SURVEY & RE-MONUMENTATION

OCT 03 1996

COMMISSION

LAND CORNER RECORDATION CERTIFICATE
Filing Requirement of Act 74, Mich. P.A. 1970

For corners in

Gogebic

(County)

Located In:

Corner Code #

- | | | | | | |
|------------------------------------|---|------------|---|------------|-------------|
| 1. Public Land Survey | T | <u>48N</u> | R | <u>47W</u> | <u>H-11</u> |
| | T | _____ | R | _____ | _____ |
| | T | _____ | R | _____ | _____ |
| | T | _____ | R | _____ | _____ |
| 2. Property Controlling in Section | S | _____ | T | _____ | _____ |
| | S | _____ | T | _____ | _____ |
| 3. Miscellaneous | S | _____ | T | _____ | _____ |
| Property in Sec. | S | _____ | T | _____ | _____ |

Register's Office }
Gogebic County } ss.

Received for record the
10TH day of JUNE
A. D. 1996 at 9:40 o'clock
A m., and recorded in
Liber 5 of CORNER
on page 354.
Ramona Collins, Deputy
Register of Deeds

Register of Deeds Stamp & File Number

4. Lot No. _____, Recorded Plat _____
5. Private Claims _____

1/4 cor. comm. to sec's 27 & 34

I, John P. Goss, in a field survey on May 15, 19 96, do hereby certify that under requirements of P.A. 74, Michigan P.A. of 1970, the corner points mentioned in lines 1 and 2 above were in conformance with regulations and rules therefore as required in the current manual of survey instructions of the United States Department of the Interior, Bureau of Land Management or by a decree of a Court of Law and/or that the corner points mentioned in lines 3, 4 and 5 above were in conformance with the rules of the Michigan Board of Land Surveyors or by a Decree of a Court of Law; established, re-established, monumented, re-monumented, recovered, found as expressed below:

	A	B	C	D	E	F	G	H	I	J	K	L	M
2	6		5		4		3		2		1		
3													
4	7		8		9		10		11		12		
5													
6	18		17		16		15		14		13		
7													
8	19		20		21		22		23		24		
9													
10	30		29		28		27		26		25		
11													
12	31		32		33		34		35		36		
13													

NOTE: Not more than 4 corners, all in the same town and range, may be recorded on this certificate.

A. Description of original monument and accessories and/or subsequent restoration:

Original corner established by William Ives on Sept. 1848. Set post.
Original bearing trees: Sugar 22" N 46° W 11 links
Fir 7" S 39° W 5 links

John R. Garske at intersection of Airport Road and Pump Station Road placed a 3/8" by 24" iron rebar. He recorded said corner position in Liber 2 on page 723 of Land Corners for Gogebic County. The following reference Objects were established. D.H. Nail in P. Pole-N 57°W - 48.43' and D.H. Nail in P. Pole-S 40° W - 49.16'.

B. Description of corner evidence found and/or method applied in restoring or reestablishing corner:

I found the 3/8 inch iron rebar, 2 inches below asphalt surface and it checked with the witnesses in John R. Garske certification. I updated the corner monument and accessories as noted below to state and county specification.


Act 74 reseach on file.

PEER GROUP APPROVED
Richard E. Decker 6/6/96
COUNTY REPRESENTATIVE

C. Description of monument for corner and accessories established to perpetuate locating the position of the corner:

I drove the 3/8" rebar down and at 1" below asphalt surface I set a 2 1/2" brass cap with a 2" stem. Cap is stamped T.48 N., R.47 W.; 1/4; S-27, S-34; 1996, P.S. 23509. I established the following bearing trees and reference objects.

- D.H. Nail in P. Pole N 57° W 48.43'
- D.H. Nail in P. Pole S 40° W 49.16'
- D.H. Nail in P. Pole N 67° E 99.68'
- Reference Monument consisting of 2 1/2" by 30"
- Aluminum monument with a 3 1/4" aluminum cap stamped to indicated corner position.
- S 44° E - 65.02' with 6' rail and sign 1.27'

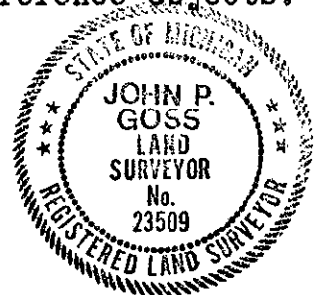

Signed by John P Goss
Surveyor's Michigan License No. 23509

Date May 16, 1996

Fed. No. V-15