SURVEY &
REMONUMENTATION

JUN 2 9 1995

COMMISSION

LAND CORNER RECORDATION CERTIFICATE

Filing Requirement of Act 74, Mich. P.A. 1970

Register's Office
Gogebic County } ss.

Received for record the 12TH day of APRIL A. D. 1995 at 1:30 o'clock P m., and recorded in Liber 5 of CORNERS on page 245.

Ramona Collins Deputy
Register of Deeds

Register of Deeds Stamp & File Number

For corners in

Gogebic (County)

		Located In:	Corner Code ##
1. Public Land Survey	S-15	T ~~48N~~ R ~~47W~~	~~I-6~~
		T ____ R ____	
		T ____ R ____	
		T ____ R ____	
2. Property Controlling	S ____	T ____ R ____	
in Section	S ____	T ____ R ____	
3. Miscellaneous	S ____	T ____ R ____	
Property in Sec.	S ____	T ____ R ____	

4. Lot No. _____ , Recorded Plat _____
5. Private Claims _____

One-quarter corner common to Sections 14 and 15, T47N, R48W

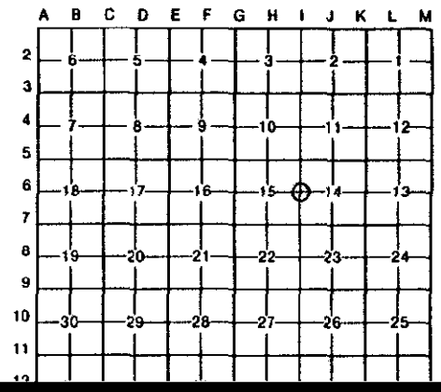

I, ~~John R. Garske~~, in a field survey on March 29, 19 95, do hereby certify that under requirements of P.A. 74, Michigan P.A. of 1970, the corner points mentioned in lines 1 and 2 above were in conformance with regulations and rules therefore as required in the current manual of survey instructions of the United States Department of the Interior, Bureau of Land Management or by a decree of a Court of Law and/or that the corner points mentioned in lines 3, 4 and 5 above were in conformance with the rules of the Michigan Board of Land Surveyors or by a Decree of a Court of Law; *established, re-established, monumented, re-monumented, recovered, found* as expressed below:

NOTE: Not more than 4 corners, all in the same town and range, may be recorded on this certificate.