

**SURVEY & REMONUMENTATION**  
**APR 07 1995**  
**COMMISSION**

**LAND CORNER RECORDATION CERTIFICATE**  
**Filing Requirement of Act 74, Mich. P.A. 1970**

Register's Office }  
 Gogebic County } ss.

For corners in  
Gogebic  
 (County)

Located In: Corner Code -#

- |                                    |              |              |             |
|------------------------------------|--------------|--------------|-------------|
| 1. Public Land Survey              | T <u>48N</u> | R <u>47W</u> | <u>I-10</u> |
| Section 26                         | T _____      | R _____      | _____       |
|                                    | T _____      | R _____      | _____       |
|                                    | T _____      | R _____      | _____       |
| 2. Property Controlling in Section | S _____      | T _____      | R _____     |
|                                    | S _____      | T _____      | R _____     |
| 3. Miscellaneous Property in Sec.  | S _____      | T _____      | R _____     |
|                                    | S _____      | T _____      | R _____     |

Received for record the  
21<sup>ST</sup> day of OCTOBER  
 A. D. 1994 at 11:15 o'clock  
A m., and recorded in  
 Liber 5 of CORNERS  
 on page 155.

Armona Collins Deputy  
 Register of Deeds

Register of Deeds Stamp & File Number


4. Lot No. \_\_\_\_\_, Recorded Plat \_\_\_\_\_  
 5. Private Claims \_\_\_\_\_  
1/4 Cor. comm. to sec's. 26 and 27

	A	B	C	D	E	F	G	H	I	J	K	L	M
2	6	5	4	3	2								
3													
4	7	8	9	10	11	12							
5													
6	18	17	16	15	14	13							
7													
8	19	20	21	22	23	24							
9													
10	30	29	28	27	26	25							
11													
12	31	32	33	34	35	36							
13													

I, John P. Goss, in a field survey on September 10, 19 94, do hereby certify that under requirements of P.A. 74, Michigan P.A. of 1970, the corner points mentioned in lines 1 and 2 above were in conformance with regulations and rules therelore as required in the current manual of survey instructions of the United States Department of the Interior, Bureau of Land Management or by a decree of a Court of Law and/or that the corner points mentioned in lines 3, 4 and 5 above were in conformance with the rules of the Michigan Board of Land Surveyors or by a Decree of a Court of Law; established, re-established, monumented, re-monumented, recovered, found as expressed below:

**NOTE: Not more than 4 corners, all in the same town and range, may be recorded on this certificate.**

A. Description of original monument and accessories and/or subsequent restoration:  
 Original survey by William Ives in 1848, Set a post.  
 Original bearing trees.  
 Hemlock 12" S57°E 44 links  
 Sugar 12" N28°W 14 links

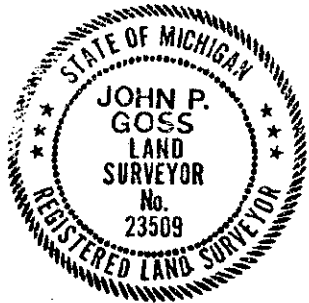

B. Description of corner evidence found and/or method applied in restoring or reestablishing corner:  
 No original evidence could be found due to road construction. Shown on Gogebic County Road Commission plans of Lake Road in 1928 as being at station 671+19.3.  
 Railroad spike in place and used on airport project in 1971.  
 Postion is opposite a fence line to the West.

Act 74 research on file with the County Register of Deeds Office.

**PEER GROUP** Approved  
Richard P. Deahn 10/12/94

C. Description of monument for corner and accessories established to perpetuate locating the position of the corner:  
 A P.K. nail marks the corner postion with RR Spike under bit. surface from which I established the following bearing objects.

I set reference monuments #1 and #2 consisting of 2½" diameter x 30" long aluminum pipe with ¾" diameter cap stamped to note the corner postion as follows:

- |                              |       |        |                    |       |
|------------------------------|-------|--------|--------------------|-------|
| R.M. #1                      | S51°W | 38.98' | - steel sign post- | 0.95' |
| R.M. #2                      | S63°E | 36.34' | - steel sign post- | 1.10' |
| D.H. nail & tag in 14" Maple | N56°E | 57.25  |                    |       |
| D.H. nail & tag in 8" Maple  | N72°W | 36.43' |                    |       |

Signed by John P Goss Date 9-16-94  
 Surveyor's Michigan License No. P.S. 23509

