

SURVEY & REMONUMENTATION

OCT 03 1996

COMMISSION

LAND CORNER RECORDATION CERTIFICATE
Filing Requirement of Act 74, Mich. P.A. 1970

Register's Office }
 Gogebic County } ss.

For corners in
Gogebic
 (County)

Located In: Corner Code #

- | | | |
|------------------------------------|---------------------------|-------------|
| 1. Public Land Survey | T <u>48N</u> R <u>47W</u> | <u>I-11</u> |
| | T _____ R _____ | _____ |
| | T _____ R _____ | _____ |
| | T _____ R _____ | _____ |
| 2. Property Controlling in Section | S _____ T _____ R _____ | _____ |
| | S _____ T _____ R _____ | _____ |
| 3. Miscellaneous Property in Sec. | S _____ T _____ R _____ | _____ |
| | S _____ T _____ R _____ | _____ |

Received for record the
10TH day of JUNE
 A. D. 1996 at 9:40 o'clock
9 m., and recorded in
 Liber 5 of CIRNARS
 page 355
Ramona Collins Deputy
 Register of Deeds
 Register of Deeds Stamp & File Number

4. Lot No. _____, Recorded Plat _____

5. Private Claims _____

Sec. cor. comm. to sec's 26, 27, 34 & 35

I, John P. Goss, in a field survey on May 17, 1996

do hereby certify that under requirements of P.A. 74, Michigan P.A. of 1970, the corner points mentioned in lines 1 and 2 above were in conformance with regulations and rules therefore as required in the current manual of survey instructions of the United States Department of the Interior, Bureau of Land Management or by a decree of a Court of Law and/or that the corner points mentioned in lines 3, 4 and 5 above were in conformance with the rules of the Michigan Board of Land Surveyors or by a Decree of a Court of Law; established, re-established, monumented, re-monumented, recovered, found as expressed below:

NOTE: Not more than 4 corners, all in the same town and range, may be recorded on this certificate.

	A	B	C	D	E	F	G	H	I	J	K	L	M
2	6	5	4	3	2	1							
3													
4	7	8	9	10	11	12							
5													
6	18	17	16	15	14	13							
7													
8	19	20	21	22	23	24							
9													
10	30	29	28	27	26	25							
11													
12	31	32	33	34	35	36							
13													

A. Description of original monument and accessories and/or subsequent restoration:

Original corner established by William Ives on Sept. 13, 1848. Set post
 Original bearing trees: Hemlock 9" S 36° W 5 links
 Cedar 14" N 23° E 29 links

John P. Goss on July 20, 1981 recovered a 1/2" rebar, using on airport project in early 1970. He recorded said corner in Liber 2 on pages 316 and 317. The following reference objects were established. D.H. Nail in P.Pole- S 19° W- 76.12'; D.H. Nail in P.Pole- S 62° E-66.89'; D.H. Nail in Indianhead Sign- N 36° E- 38.49'

B. Description of corner evidence found and/or method applied in restoring or reestablishing corner:

By using witnesses from above certification I set a P.K. Nail over the metal bar below asphalt surface. I updated the corner monument and accessories as noted below to state and county specification.

Act 74 reseach on file.


PEER GROUP APPROVED

Richard L. Drake 6/6/96
 COUNTY REPRESENTATIVE

C. Description of monument for corner and accessories established to perpetuate locating the position of the corner:

P.K. Nail in intersection of Airport and Lake Roads marks the corner position from which I established the following bearing objects.

- | | | | |
|---------------------|---------|--------|----------------------|
| R.M. | N 33° E | 51.92' | 6' rail & sign 1.13' |
| R.M. | S 67° W | 82.44' | 6' rail & sign 1.10' |
| D.H. Nail in P.Pole | S 19° W | 76.12' | |
| D.H. Nail in P.Pole | S 62° E | 66.89' | |

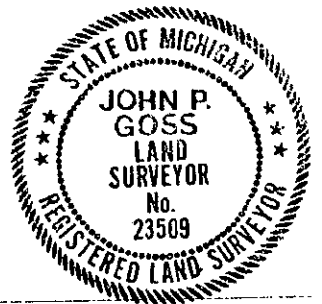

Signed by John P. Goss

Date May 17, 1996

Surveyor's Michigan License No. 23509