

**SURVEY &
REMONUMENTATION**

OCT 03 1996

COMMISSION

**LAND CORNER RECORDATION CERTIFICATE
Filing Requirement of Act 74, Mich. P.A. 1970**

For corners in

<u>Gogebic</u> <small>(County)</small>	Located In:	Corner Code #
1. Public Land Survey	T <u>48N R 47W</u>	<u>J-5</u>
	T _____ R _____	_____
	T _____ R _____	_____
	T _____ R _____	_____
2. Property Controlling in Section	S _____ T _____ R _____	_____
	S _____ T _____ R _____	_____
3. Miscellaneous Property in Sec.	S _____ T _____ R _____	_____
	S _____ T _____ R _____	_____

Register's Office }
Gogebic County } ss.

Received for record the
10th day of JUNE
A. D. 19 96 at 9:48 o'clock
A m., and recorded in
Liber 5 of CORNERS
on page 356.


Ramona Collins, Deputy
Register of Deeds

Register of Deeds Stamp & File Number

4. Lot No. _____, Recorded Plat _____
5. Private Claims _____

1/4 cor. comm. to sec's. 11 & 14

I, John P. Goss, in a field survey on May 30, 19 96, do hereby certify that under requirements of P.A. 74, Michigan P.A. of 1970, the corner points mentioned in lines 1 and 2 above were in conformance with regulations and rules therefore as required in the current manual of survey instructions of the United States Department of the Interior, Bureau of Land Management or by a decree of a Court of Law and/or that the corner points mentioned in lines 3, 4 and 5 above were in conformance with the rules of the Michigan Board of Land Surveyors or by a Decree of a Court of Law; established, re-established, monumented, re-monumented, recovered, found as expressed below:

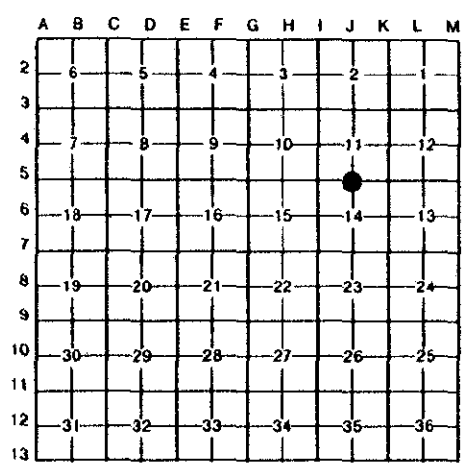

NOTE: Not more than 4 corners, all in the same town and range, may be recorded on this certificate.

A. Description of original monument and accessories and/or subsequent restoration:

Original corner established by William Ives on Sept. 15, 1848. 12" Cedar.
Original bearing tree : Fir 8" N 80° E 8 links

In 1992 Robert Mick P.S. set a 3/8" by 24" rebar with yellow cap No. L.S. 16936 on line and mid-way between Section corners. He recorded said corner position in Liber 4 on Page 89 of Land Corners for Gogebic County. He established the following bearing trees and reference objects. 8" Black Ash- S 85° E- 15.42'; 10" Cedar- N 40° E- 16.24'; 10" Black Ash- N 68° W- 15.66'; 10" Black Ash- S 60° W- 6.77'.

B. Description of corner evidence found and/or method applied in restoring or reestablishing corner:

I found the 3/8 rebar with yellow cap No. 16936 set by Robert Mick. It checked with Mick witnesses. I updated the corner monument and accessories as noted below to state and county specification.


Act 74 reseach on file.

PEER GROUP APPROVED
Richard P. Dorn 6/6/96
COUNTY REPRESENTATIVE

C. Description of monument for corner and accessories established to perpetuate locating the position of the corner:

I replaced the 3/8" rebar with a 2 1/2" by 30" aluminum pipe with a 3 1/4" aluminum cap stamped: County Remonumentation; S-11, S-14; 1/4; 1996; P.S. 23509. I established the following bearing trees and reference objects;

- | | | |
|----------------|---------|--------|
| 10" Black Ash | S 85° E | 15.42' |
| 10" Cedar | N 40° E | 16.24' |
| 12" Black Ash | N 68° W | 15.66' |
| 10" Black Ash | S 60° W | 6.77' |
| 6' rail & sign | S 25° W | 1.02' |

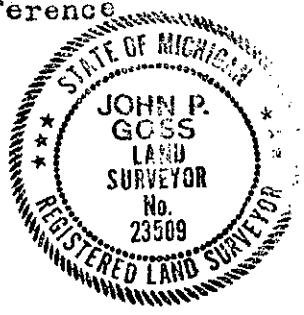

Signed by John P Goss
Surveyor's Michigan License No. 23509

Date May 31, 1996

Fed. No. J-19

356