

SURVEY & MONUMENTATION

OCT 03 1996

COMMISSION

LAND CORNER RECORDATION CERTIFICATE
Filing Requirement of Act 74, Mich. P.A. 1970

Register's Office }
Gogebic County } ss.

Received for record the
10TH day of JUNE
A. D. 1996 at 9:40 o'clock
A m., and recorded in
Liber 5 of CORNERS
on page 359
Ramona Collins Deputy
Register of Deeds

Register of Deeds Stamp & File Number

For corners in Gogebic (County)

Located In: Corner Code #

1. Public Land Survey	T <u>48N</u> R <u>47W</u>	<u>K-11</u>
	T _____ R _____	_____
	T _____ R _____	_____
	T _____ R _____	_____
2. Property Controlling in Section	S _____ T _____ R _____	_____
	S _____ T _____ R _____	_____
3. Miscellaneous Property in Sec.	S _____ T _____ R _____	_____
	S _____ T _____ R _____	_____

4. Lot No. _____, Recorded Plat _____

5. Private Claims _____

Section corner comm. to sec's. 25, 26, 35 & 36

	A	B	C	D	E	F	G	H	I	J	K	L	M
2	6	5	4	3	2	1							
3													
4	7	8	9	10	11	12							
5													
6	18	17	16	15	14	13							
7													
8	19	20	21	22	23	24							
9													
10	30	29	28	27	26	25							
11													
12	31	32	33	34	35	36							
13													

I, John P. Goss, in a field survey on May 9, 1996, do hereby certify that under requirements of P.A. 74, Michigan P.A. of 1970, the corner points mentioned in lines 1 and 2 above were in conformance with regulations and rules therefore as required in the current manual of survey instructions of the United States Department of the Interior, Bureau of Land Management or by a decree of a Court of Law and/or that the corner points mentioned in lines 3, 4 and 5 above were in conformance with the rules of the Michigan Board of Land Surveyors or by a Decree of a Court of Law; established, re-established, monumented, re-monumented, recovered, found as expressed below:

NOTE: Not more than 4 corners, all in the same town and range, may be recorded on this certificate.

A. Description of original monument and accessories and/or subsequent restoration:

Original corner established by William Ives on Sept. 11, 1848. set post.
Original bearing trees: Sugar 22" S 55° E 8 links
Hemlock 8" N 30° W 41 links

John P. Goss recovered a 1/2" rebar on July 20, 1981 and recorded it in Liber 2 pages 316 and 317 of Land Corners for Gogebic County. The following reference object were established: P.Pole-N42°E-46.99'; P.Pole-S46E-45.84'; S.W. cor. of school outside foundation- S36W-92.96'.

B. Description of corner evidence found and/or method applied in restoring or reestablishing corner:

At 5" below asphalt surface I found the 1/2" rebar and it checked with the witnesses in John P. Goss certification. I updated the corner monument and accessories as noted below to state and county specification.

Act 74 reach on file.


PEER GROUP APPROVED

Richard E. Drain 6/6/96
COUNTY REPRESENTATIVE

C. Description of monument for corner and accessories established to perpetuate locating the position of the corner:

At 2" below asphalt surface I set a 2 1/2" brass cap with a 2" stem over the 1/2" rebar. Cap is stamped: T.48N., R.47W., S-25,S-26,S-35,S-36, 1996, P.S. 23509. I established the following bearing trees and reference objects.

- D.H. nail in P.Pole N 42° E 46.92'
- D.H. Nail in P.Pole S 46° E 45.88'
- D.H. nail in S. Post of sign N 28° W 60.78'
- Reference Monument consisting of a 2 1/2" by 30"
- Aluminum monument with a 3 1/4" aluminum cap stamped to indicate corner position:
- S 27° W- 46.82'

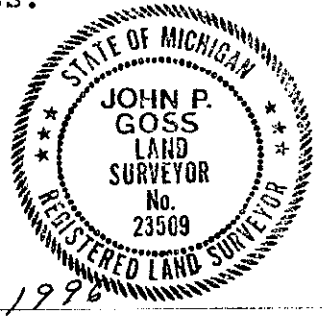

Signed by John P Goss Date May 12, 1996
Surveyor's Michigan License No. 23509