

LAND CORNER RECORDATION CERTIFICATE
Filing Requirement of Act 74, Mich. P.A. 1970

Register's Office }
Gogebic County } ss.

For corners in

Gogebic
(County)

Located In: Corner Code #

Received for record the
30th day of DECEMBER
A. D. 1993 at 12:25 o'clock
P. m., and recorded in
Liber 4 of CORNERS
on page 331

Betty Loria Deputy
Register of Deeds

Register of Deeds Stamp & File Number

- 1. Public Land Survey T 47N R 47W K-1
T R
T R
T 48N R 47W K-13
- 2. Property Controlling in Section S T R
S T R
- 3. Miscellaneous Property in Sec. S T R
S T R

4. Lot No. , Recorded Plat

5. Private Claims

Section corner common to S-1 & S-2, T47N, R47W and
S-35 & S-36, T48N, R47W.

I, John R. Garske, in a field survey on December 27, 1993, do hereby certify that under requirements of P.A. 74, Michigan P.A. of 1970, the corner points mentioned in lines 1 and 2 above were in conformance with regulations and rules therefore as required in the current manual of survey instructions of the United States Department of the Interior, Bureau of Land Management or by a decree of a Court of Law and/or that the corner points mentioned in lines 3, 4 and 5 above were in conformance with the rules of the Michigan Board of Land Surveyors or by a Decree of a Court of Law; established, re-established, monumented, re-monumented, recovered, found as expressed below:

NOTE: Not more than 4 corners, all in the same town and range, may be recorded on this certificate.

	A	B	C	D	E	F	G	H	I	J	K	L	M
2	6	5	4	3	2	1							
3													
4	7	8	9	10	11	12							
5													
6	18	17	16	15	14	13							
7													
8	19	20	21	22	23	24							
9													
10	30	29	28	27	26	25							
11													
12	31	32	33	34	35	36							
13													

A. Description of original monument and accessories and/or subsequent restoration:

Original Evidence:

Survey by William A. Burt on August 24, 1848. Set Y. birch post from which an 8" hemlock bears N48°E, 34 links and a 9" sugar bears N50°W, 14 links.

Subsequent Restoration:

United States Department of Agriculture, 1938. Set 5" x 42" concrete monument with a stamped brass cap from which a fence post - south 29.2 feet and a 12" basswood - N52°E - 14.82 feet and a 5" birch - N20°W - 17.97 feet

B. Description of corner evidence found and/or method applied in restoring or reestablishing corner:

Restored corner position from found accessories from 1938 U.S.D.A. survey. No original evidence of corner could be located. The corner falls approximately 6 feet north of an East-West trail.

PEER GROUP APPROVED


Richard P. Dealm 3/1/95

COUNTY REPRESENTATIVE

C. Description of monument for corner and accessories established to perpetuate locating the position of the corner:

Set 2 1/2" x 30" aluminum county monument with a 3 1/2" stamped aluminum cap. Established the following bearing trees and reference objects:

- P. pole #35-95/06 - N24°E - 35.55 feet
- 6" sugar in clump - S07°E - 42.12 feet
- 5" sugar - S69°W - 65.98 feet
- Steel sign post - north - 1.28 feet

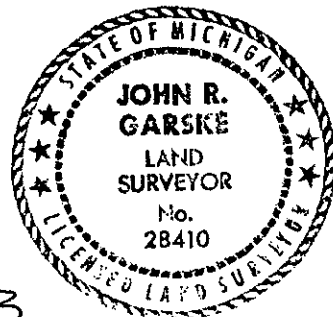

Signed by John R Garske

Date 12/29/93

Surveyor's Michigan License No. 28410