

SURVEY & REMONUMENTATION COMMISSION
 APR 07 1995

LAND CORNER RECORDATION CERTIFICATE
 Filing Requirement of Act 74, Mich. P.A. 1970

Register's Office }
 Gogebic County } ss.

For corners in _____ Gogebic _____ Located In: _____ Corner Code ## _____
 (County)

Received for record the
21st day of OCTOBER
 A. D. 1994 at 11:20 o'clock
A m., and recorded in
 Liber 5 of CORNEAS
 on page 156
Bernora Collins Deputy
 Register of Deeds

1. Public Land Survey Section 25	T <u>48N</u> R <u>47W</u>	<u>L-11</u>
	T _____ R _____	_____
	T _____ R _____	_____
	T _____ R _____	_____
2. Property Controlling in Section	S _____ T _____ R _____	_____
	S _____ T _____ R _____	_____
3. Miscellaneous Property in Sec.	S _____ T _____ R _____	_____

Register of Deeds Stamp & File Number

4. Lot No. _____ Recorded Plat _____
 5. Private Claims _____

1/4 Cor. Comm. to Sec's. 25 and 36


I, John P. Goss, in a field survey on September 10, 1994, do hereby certify that under requirements of P.A. 74, Michigan P.A. of 1970, the corner points mentioned in lines 1 and 2 above were in conformance with regulations and rules therefore as required in the current manual of survey instructions of the United States Department of the Interior, Bureau of Land Management or by a decree of a Court of Law and/or that the corner points mentioned in lines 3, 4 and 5 above were in conformance with the rules of the Michigan Board of Land Surveyors or by a Decree of a Court of Law; established, re-established, monumented, re-monumented, recovered, found as expressed below:

A	B	C	D	E	F	G	H	I	J	K	L	M
2	6	5	4	3	2							
3												
4	7	8	9	10	11	12						
5												
6	18	17	16	15	14	13						
7												
8	19	20	21	22	23	24						
9												
10	30	29	28	27	26	25						
11												
12	31	32	33	34	35	36						
13												

NOTE: Not more than 4 corners, all in the same town and range, may be recorded on this certificate.

A. Description of original monument and accessories and/or subsequent restoration:
 Original survey by William Ives in 1848. Set a post.
 Original bearings trees.

Maple 8" N26°E 22 links
 Y. Birch 12" S35°W 39 links

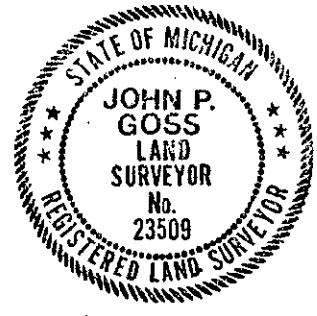

B. Description of corner evidence found and/or method applied in restoring or reestablishing corner:
 No original evidence of corner location could be found due to road construction.
 Set by single proportion measurement between recorded section corners.
 Act 74 research on file with the County Register of Deeds Office.

PEER GROUP Approved
Richard P. Dehn 10/12/94

C. Description of monument for corner and accessories established to perpetuate locating the position of the corner:
 A P.K. nail marks the corner position from which I established the following bearing objects.

I set reference monument #1 and #2 consisting of 2 1/2" diameter x 30" long aluminum pipe with 3/4" diameter cap stamped to note the corner position as follows:

R.M. #1 N42°W 43.90' - steel sign post- 1.04'
 R.M. #2 S43°W 43.53' - steel sign post- 1.20'
 D.H. nail & tag in P.Pole S36°E 40.84'
 D.H. nail & tag in G.Pole N42°E 40.77'

Signed by John P Goss Date 9/16/94
 Surveyor's Michigan License No. P.S. 23509

