

MAY 16 1997

COMMISSION

LAND CORNER RECORDATION CERTIFICATE
Filing Requirement of Act 74, Mich. P.A. 1970

For corners in

Gogebic
(County)

Located In:

Corner Code #

1. Public Land Survey

| | |
|-----------|-----|
| T48NR L8W | A-2 |
| T48NR L9W | M-2 |
| T R | |
| T R | |
| S T R | |
| S T R | |
| S T R | |
| S T R | |

2. Property Controlling in Section

3. Miscellaneous Property in Sec.

4. Lot No. _____, Recorded Plat _____

5. Private Claims _____

1/4 cor. common to sec's. 1 & 6

I, John P. Goss, in a field survey on Nov. 7, 1996 do hereby state that under requirements of P.A. 74, Michigan P.A. of 1970, the corner points mentioned in lines 1 and 2 above were in conformance with regulations and rules therefore as required in the current manual of survey instructions of the United States Department of the Interior, Bureau of Land Management or by a decree of a Court of Law and/or that the corner points mentioned in lines 3, 4 and 5 above were in conformance with the rules of the Michigan Board of Land Surveyors or by a Decree of a Court of Law, established, re-established, monumented, recovered, found as expressed below:

NOTE: Not more than 2 corners, all in the same town and range, may be recorded on this certificate.

Register's Office }
Gogebic County } ss.

Received for record the
12TH day of DECEMBER

A. D. 1996 at 2:30 o'clock
P m., and recorded in

Liber 6 of CORNERS

on page 88

Ramona Collins Deputy
Register of Deeds

Register of Deeds Stamp & File Number

| | | | | | | | | | | | | | |
|----|----|----|----|----|----|----|---|---|---|---|---|---|---|
| 1 | A | B | C | D | E | F | G | H | I | J | K | L | M |
| 2 | 6 | 5 | 4 | 3 | 2 | 1 | | | | | | | |
| 3 | | | | | | | | | | | | | |
| 4 | 7 | 8 | 9 | 10 | 11 | 12 | | | | | | | |
| 5 | | | | | | | | | | | | | |
| 6 | 18 | 17 | 16 | 15 | 14 | 13 | | | | | | | |
| 7 | | | | | | | | | | | | | |
| 8 | 19 | 20 | 21 | 22 | 23 | 24 | | | | | | | |
| 9 | | | | | | | | | | | | | |
| 10 | 30 | 29 | 28 | 27 | 26 | 25 | | | | | | | |
| 11 | | | | | | | | | | | | | |
| 12 | 31 | 32 | 33 | 34 | 35 | 36 | | | | | | | |
| 13 | | | | | | | | | | | | | |

A. Description of original monument and accessories and/or subsequent restoration:

Original corner established by William Ives on Aug. 11, 1848. Set Maple post.
Original bearing trees: Aspen 10" S 19° E 16 links
Aspen 10" N 36° W 6 links

John Garski found a post and it checked with natural features ties to the North. Garski accepted post and placed a 1" iron pipe with brass cap and recorded said corner in Liber 3 page 275 in October 1988. He established the following bearing trees: 4" Maple- Due West- 23.80'; 3" Maple- N 10° E- 22.05'; 8" Maple - S 72° E- 19.48'. The above Liber is for Land Corners in Gogebic County.


B. Description of corner evidence found and/or method applied in restoring or reestablishing corner:
Found the 1" iron pipe and it checked with John Garski witnesses. Two (2) of the trees are down trees now. I updated the accessories as noted below to state and county specification.

Act 74 research on file.

PEER GROUP APPROVAL
Richard P. Dealon 12/11/96
COUNCIL REPRESENTATIVE

C. Description of monument for corner and accessories established to perpetuate locating the position of the corner:
From the 1" iron pipe and brass cap marked T.48 N., R.48-49 W.; 1/4; S-1, S-6; 1988; LSS 28410. I established the existing and new bearing trees and reference objects.

| | | |
|----------------|---------|--------|
| 9" Maple | S 72° E | 19.48' |
| 6" Maple | N 71° W | 23.25' |
| 5" Maple | S 15° W | 35.94' |
| 6" Rail & Sign | North | 1.34' |

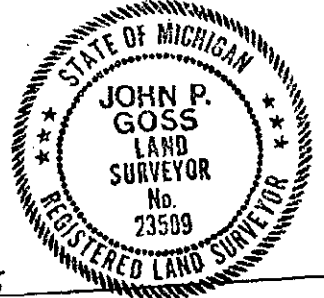

Signed by John P. Goss
Surveyor's Michigan License No. 23509

Date Nov. 8, 1996

Fed No. G-25